NE 29 30 23

Certificate of Survey

FROM THE OFFICE OF

CHARLES O. GEORGI COMPANY

2215 West County Road B Saint Paul, Minnesota 55113

REGISTERED CIVIL ENGINEER AND LAND SURVEYOR

I Hereby Certify that **this plat shows a survey made by me of the property described on this plat, and that the corners are correctly placed as shown, and that all locations have been correctly shown.**

Surveyed For Dynamic Developers

Date December 1977

Scale 1"=50'

By Charles O. Georgi
REGISTERED LAND SURVEYOR

o Denotes Iron Pipe Monument placed 9/77

Description:
Lot 10 except the North 10 feet thereof, Lot 11, and the North 6 feet of Lot 12, Block 3, First Addition to New Brighton; and all of the vacated alley adjoining said Lot 11 and the North 6 feet of Lot 12.
Ramsey County, Minn.
Subject to sewer easement over said alley

Description:
Lot 12 except the North 6 feet thereof, Lot 13, and the North 2 feet of Lot 14, Block 3, First Addition to New Brighton; and all of the vacated alley adjoining above said land.
Ramsey County, Minn
Subject to sewer easement over said alley.
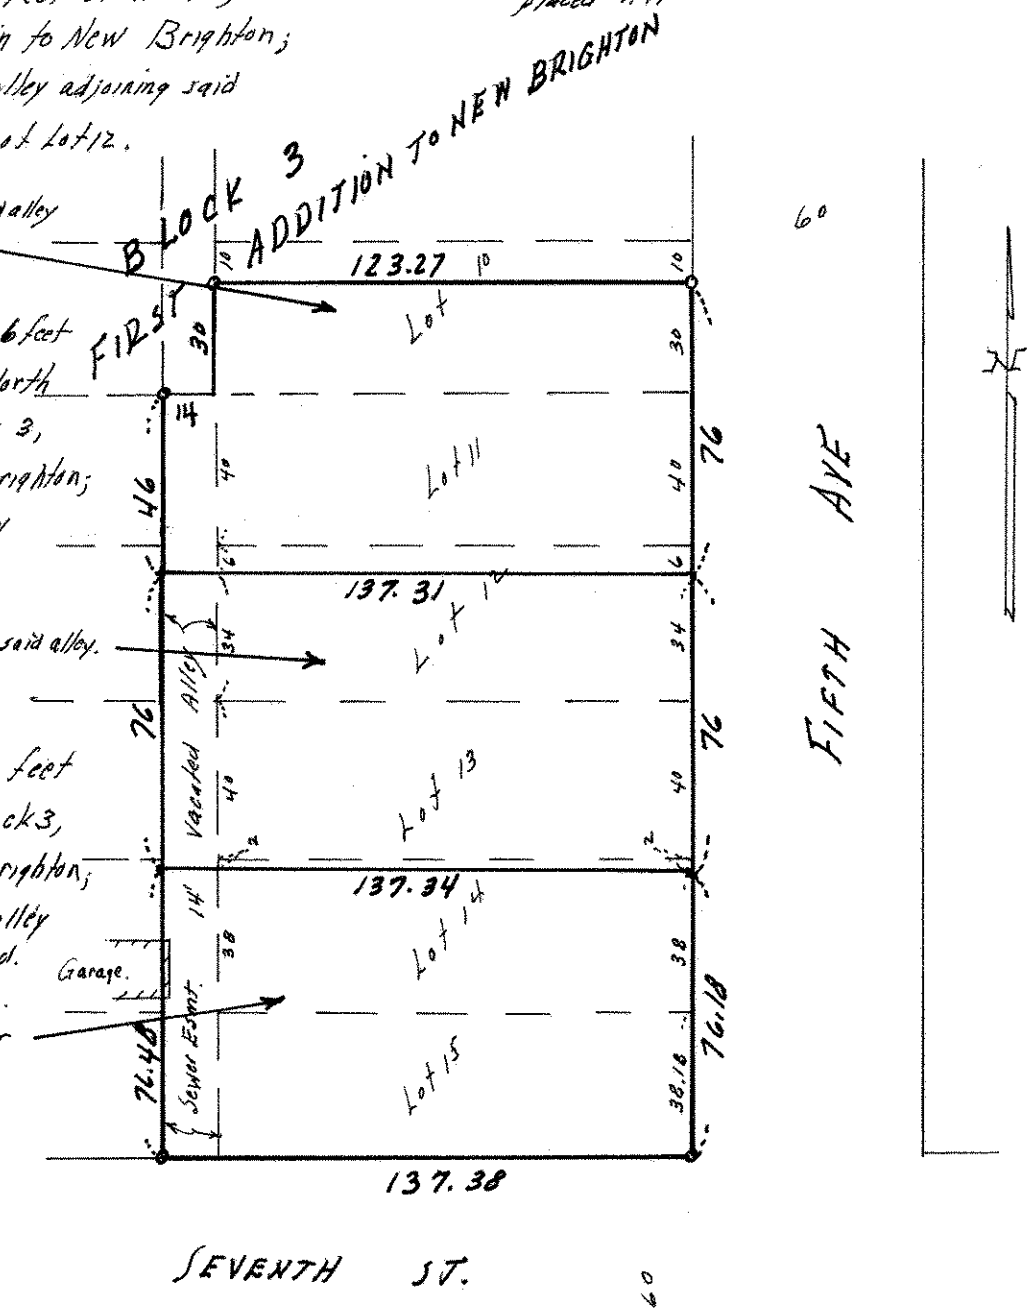
Description:
Lot 14 except the North 2 feet thereof and Lot 15, Block 3, First Addition to New Brighton; and all of the vacated alley adjoining above said land.
Ramsey County, Minn.
Subject to sewer easement over said alley