

NW 11 30 23

FROM THE OFFICE OF

CHARLES O. GEORGI COMPANY

2215 West County Road B

Saint Paul, Minnesota 55113

REGISTERED CIVIL ENGINEER AND LAND SURVEYOR



Certificate of Survey

I Hereby Certify that this plat shows a survey made by me of the property described on this plat, and that the corners are correctly placed as shown, and that all locations have been correctly shown.

Surveyed For Ernie Burrows

Date March 1978


Scale 1"=60'

By Charles O. Georgi
REGISTERED LAND SURVEYOR

Description:

Lot 9, Block 1, Birchwood Homesites

Ramsey County, Minn.

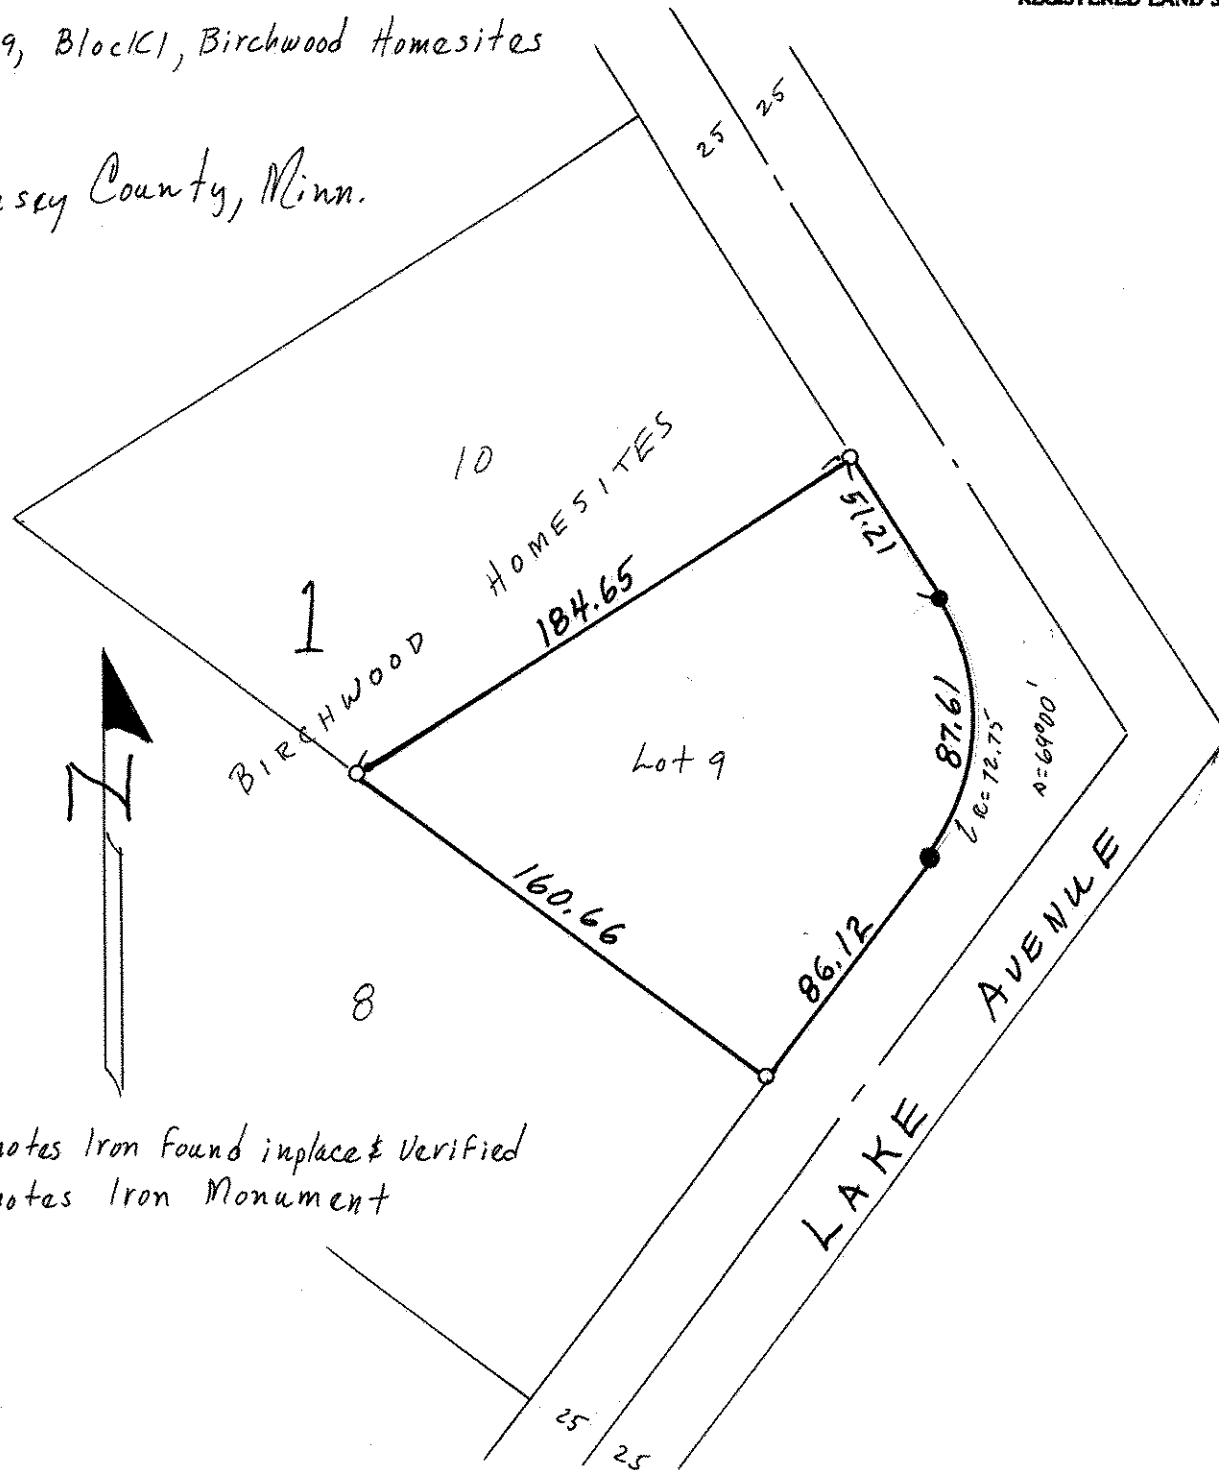

- Denotes Iron Found in place & Verified
- Denotes Iron Monument