AUG 26 1977

WEAVER OAK HEIGHTS

LOCATE LOW WET

985.1

T @ MH West of House # 1307

H1 5.3
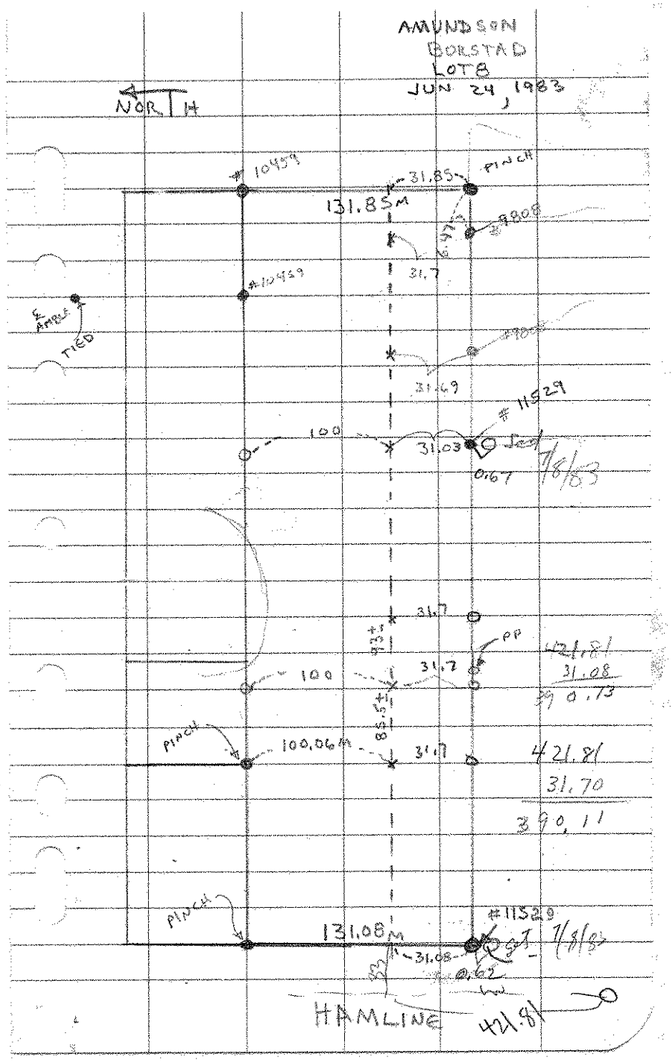
332	0°	7.85	977.2		NAIL @ ℄ HAM & AMBLE
89	155°15'	2.95	982.17		Hyd by House # 1307
222	173°25'	6.0	979.1		NAIL @ Lot Line & AMBLE
62	229°15'	12.0	73.1		Corner Low Wet
117	231°30'	12.4	72.7		"
158	240°45'	12.4	72.7		
169	253°30'	13.0	72.1		
155	283°30'	13.0	72.1		
96	288°45'	13.0	72.1		
54	292°45'	12.7	72.4