

Certificate  
of Survey

FROM THE OFFICE OF

CHARLES O. GEORGI COMPANY

2215 West County Road B

Saint Paul, Minnesota 55113

REGISTERED CIVIL ENGINEER AND LAND SURVEYOR

I Hereby Certify that this plat shows a survey made by me of the property described on this plat, and that the corners are correctly placed as shown, and that all locations have been correctly shown.

Surveyed For Jerome Weaver


Date March 1970

Scale 1"=100'

By Charles O. Georgi  
REGISTERED LAND SURVEYOR

Description:

Lot 7, Borstad, Ramsey County, Minn. except the East 500 feet thereof.

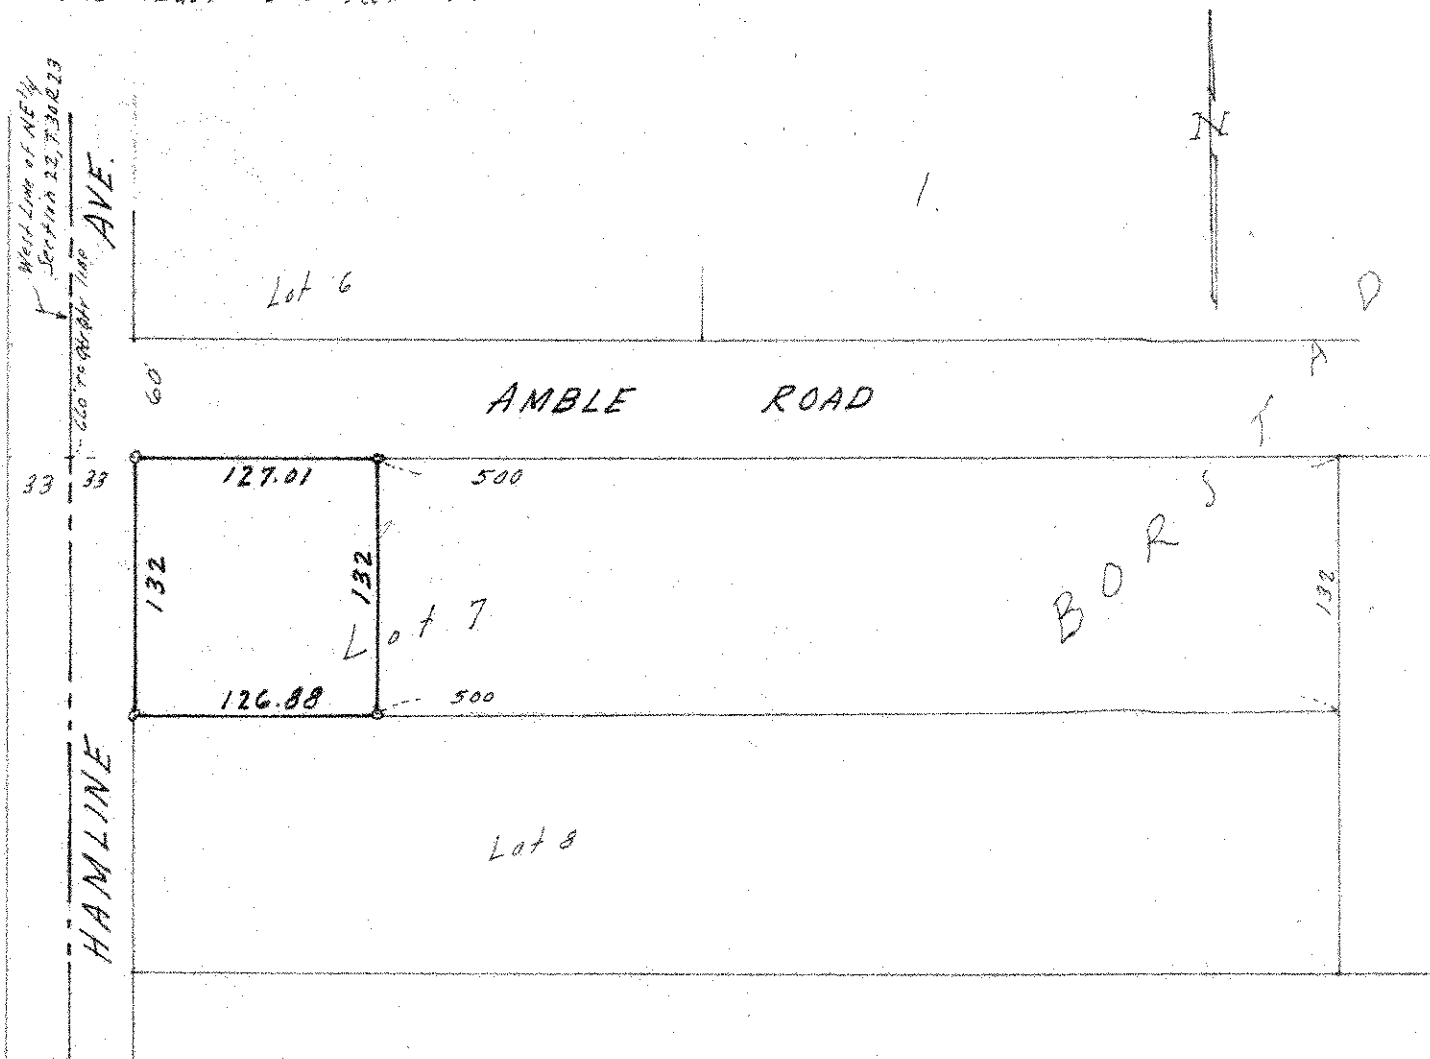

o Denotes Iron Monument.