

G.I. Loan # 262

TELEPHONE TOWER 0640


PLAT OF SURVEY

OF PROPERTY OF Jethro F. Medlin

DESCRIBED AS FOLLOWS Lot 6, Borstad Addition

SCALE: 1 INCH 50 FEET

T. J. WELCH, REGISTERED SURVEYOR
738 SURREY AVENUE, ST. PAUL, MINN.

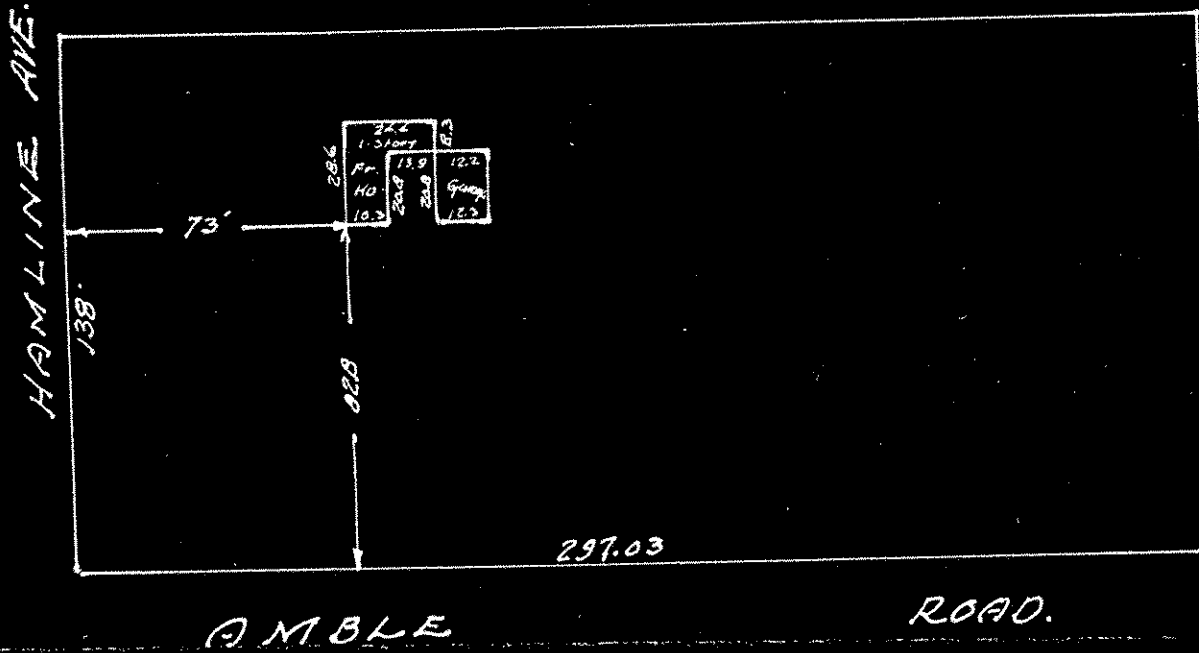

CERTIFICATE OF SURVEY

I hereby certify that on 4-2 1947.

I surveyed the property described above and that the above plat is a correct representation of said survey.

T. J. Welch