

SE 6 30 23

FROM THE OFFICE OF

CHARLES O. GEORGI COMPANY

2215 West County Road B

Saint Paul 13, Minnesota

REGISTERED CIVIL ENGINEER AND LAND SURVEYOR

Certificate of Survey

I Hereby Certify that this plat shows a survey made by me of the property described on this plat, and that the corners are correctly placed as shown, and that all locations have been correctly shown.

Surveyed For *Mr. James Hauptzok*


Date *June 1961*

Scale *1" = 100'*

Description:

By *Charles O. Georgi*
REGISTERED LAND SURVEYOR

*The North 1/2 of Lot 51
SPRING LAKE PARK HILLVIEW*

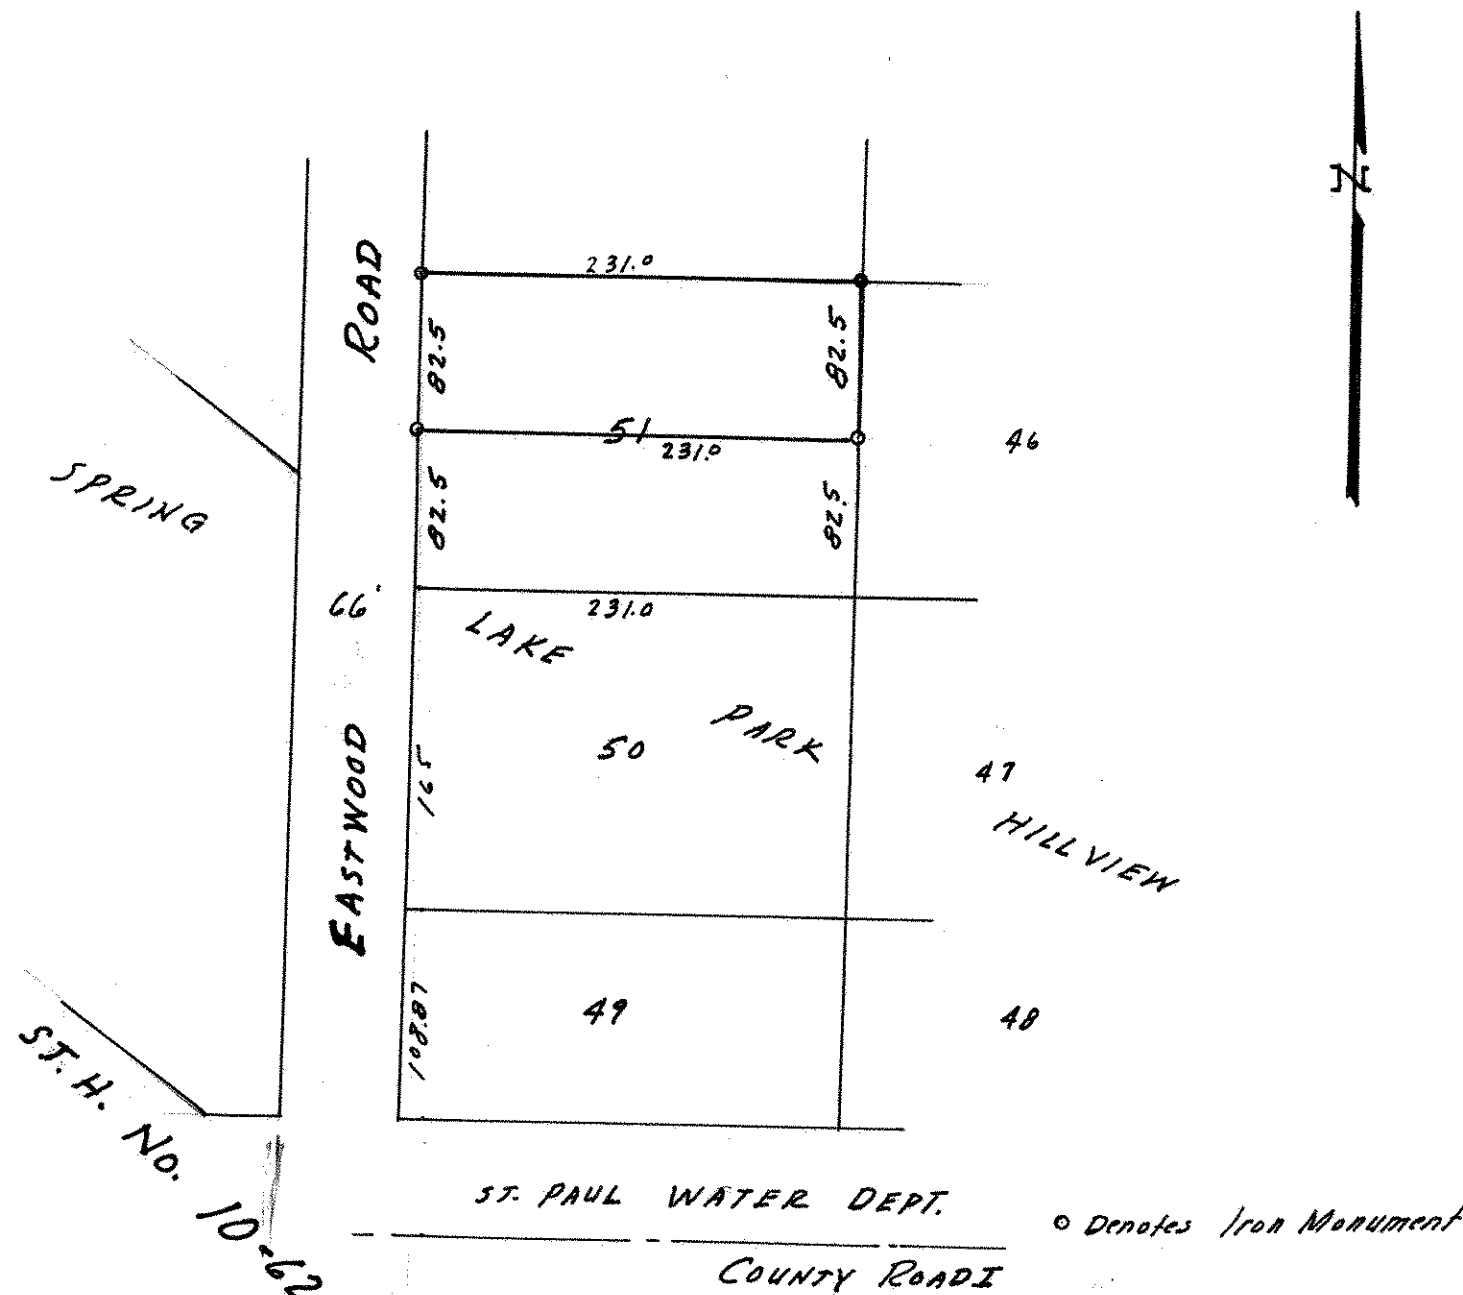

ST. H. No. 10-62

*ST. PAUL WATER DEPT.
COUNTY ROAD*

o Denotes Iron Monument