Sec. 1 - 30 - 23

LOTS 18 & 19

AKBARNUM'S GARDEN LOTS

JOHN B. IRVINE, SURVEYOR.
408 GLOBE BLDG.
ST. PAUL, MINN
MAY 15-1913.
Scale 200 ft. per. inch.

N
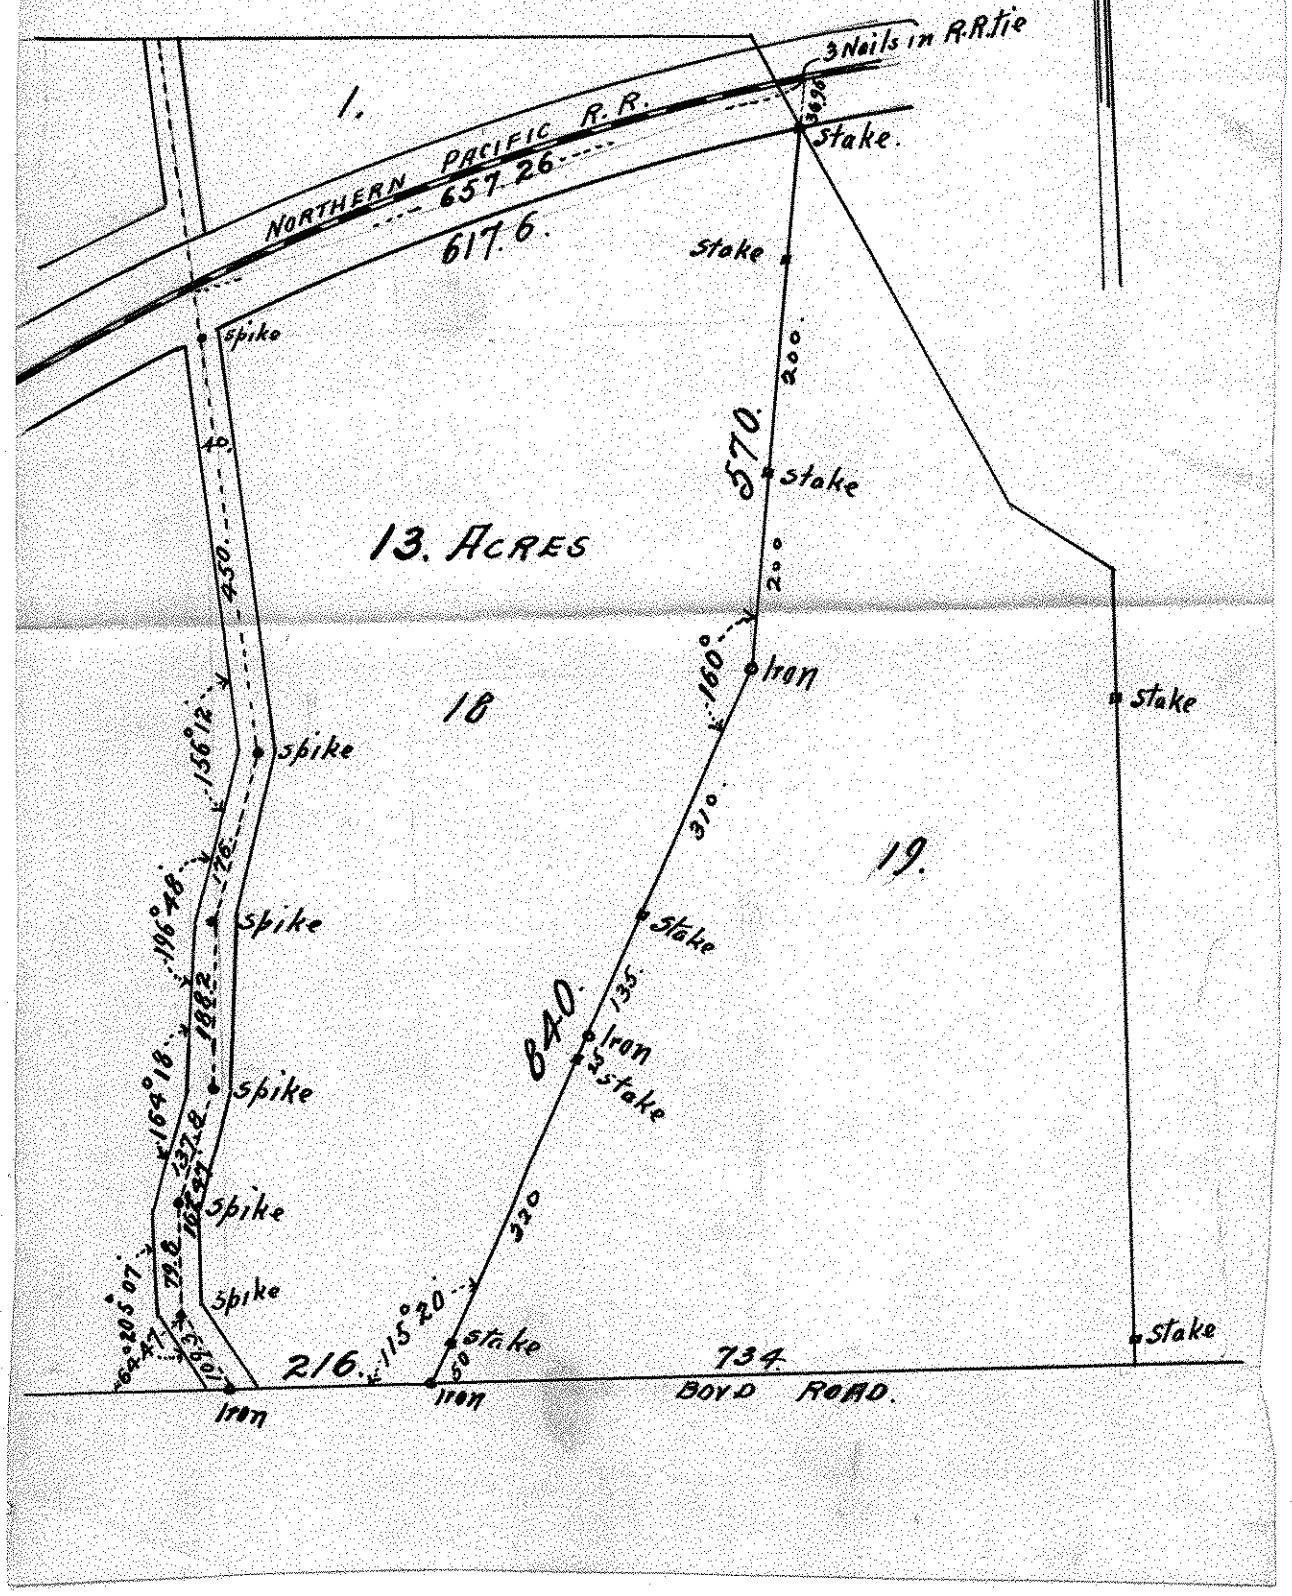
OWASSO LAKE.