NE 19 30 23

FROM THE OFFICE OF

CHARLES O. GEORGI COMPANY

2215 West County Road B — Saint Paul, Minnesota 55113

REGISTERED CIVIL ENGINEER AND LAND SURVEYOR

Certificate of Survey

I Hereby Certify that this plat shows a survey made by me of the property described on this plat, and that the corners are correctly placed as shown, and that all locations have been correctly shown.

Note: It is recommended that you consult your attorney on the 6.93 x 26.45 Triangular parcel adjoining 23 Ave. NW that was not platted as part of this addition, part of Lot 1. Marked not included.

Surveyed For Harold E. Anderson

Date May 3, 1967

Scale 1" = 30'

By Charles O. Georgi
REGISTERED LAND SURVEYOR
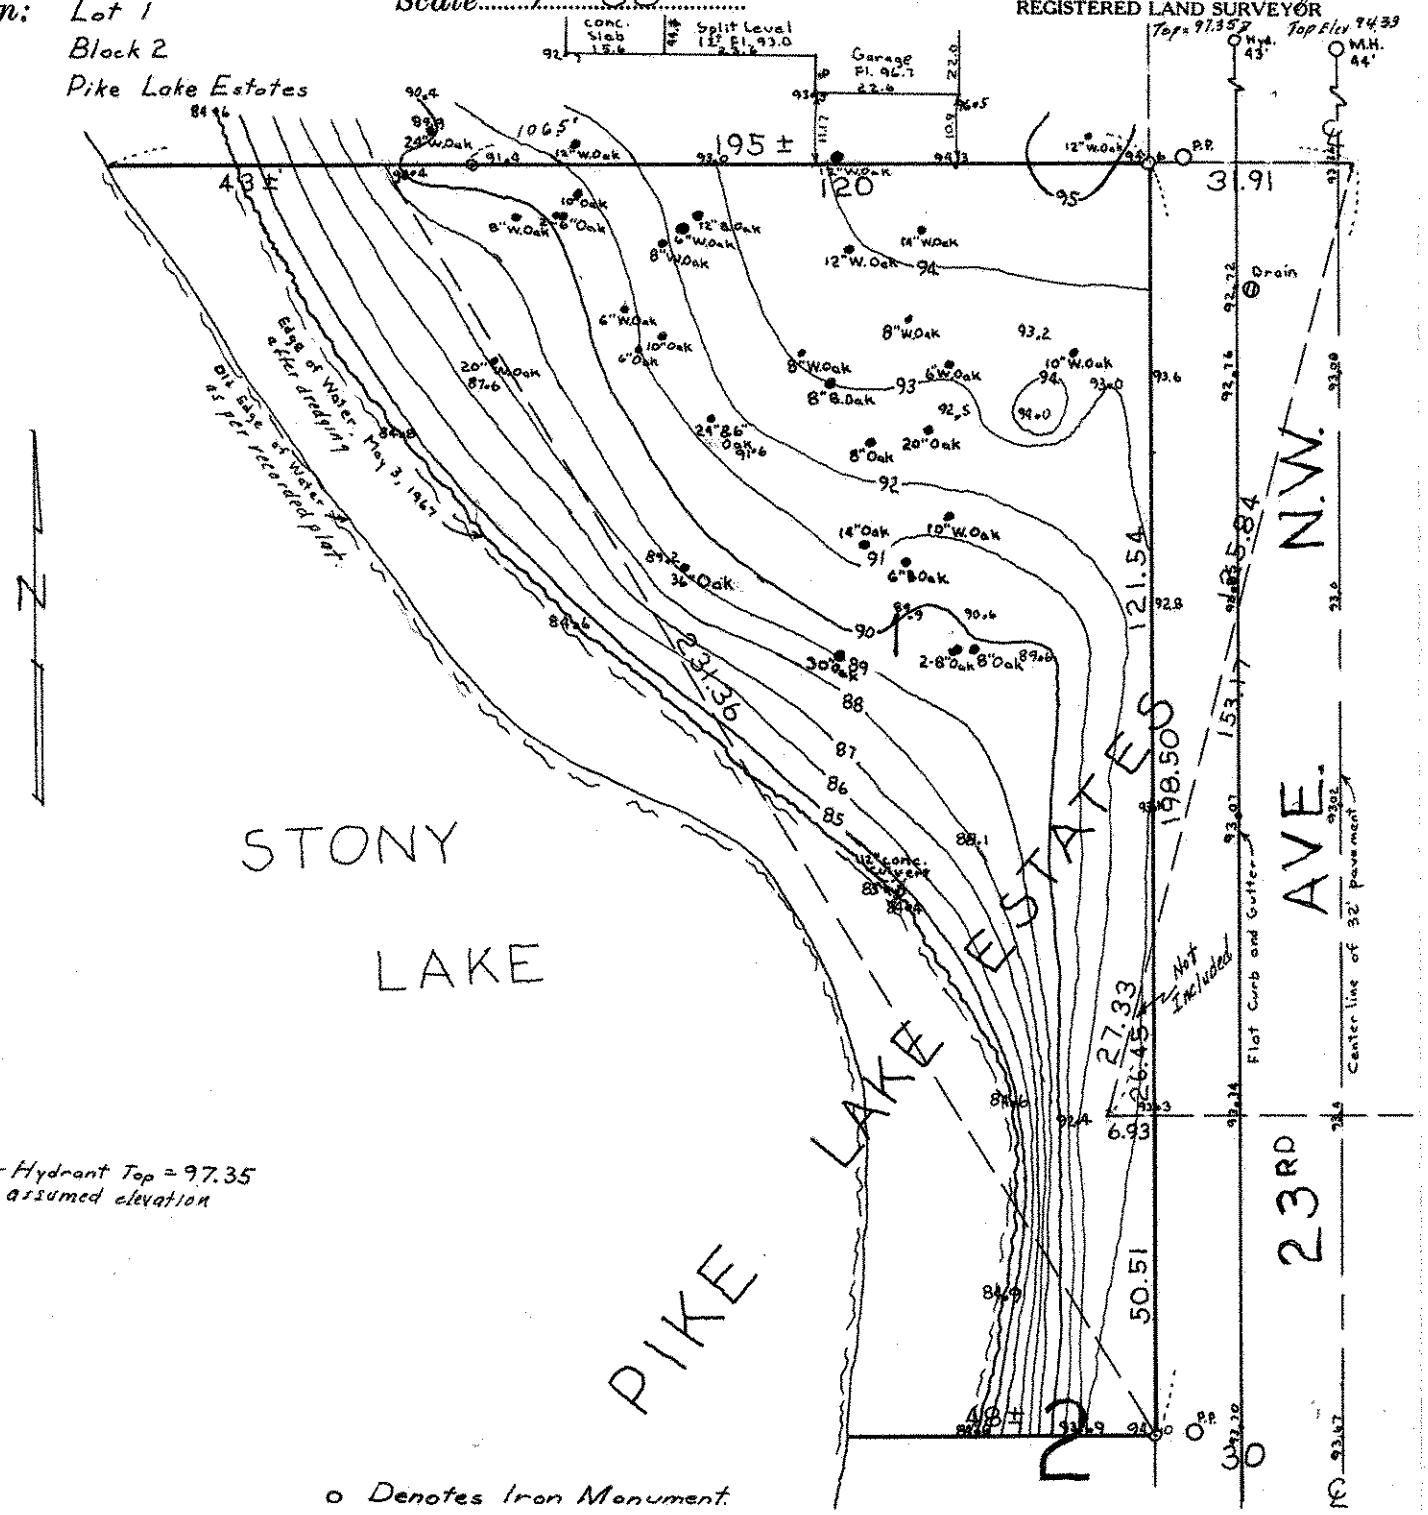
Description: Lot 1
Block 2
Pike Lake Estates