NW 36 30 23

Certificate of Survey

From the office of

GEORGI- SCHMIDT & ASSOC. INC.

3092 No. Lexington Ave., Roseville, Mn. 55113

LAND SURVEYING

483-4408

I Hereby Certify that this plat shows a survey made by me of the property described on this plat, and that the corners are correctly placed as shown, and that all locations have been correctly shown.

Job Number: _____

Surveyed For B. Wade Anderson

Date August 22 1978

Scale 1" = 40'

By Donald W. Schmidt

REGISTERED LAND SURVEYOR

Description:

Lot 17,
Block 1,
Lakeshore Oaks Addition No. 2,
Ramsey County, Minnesota

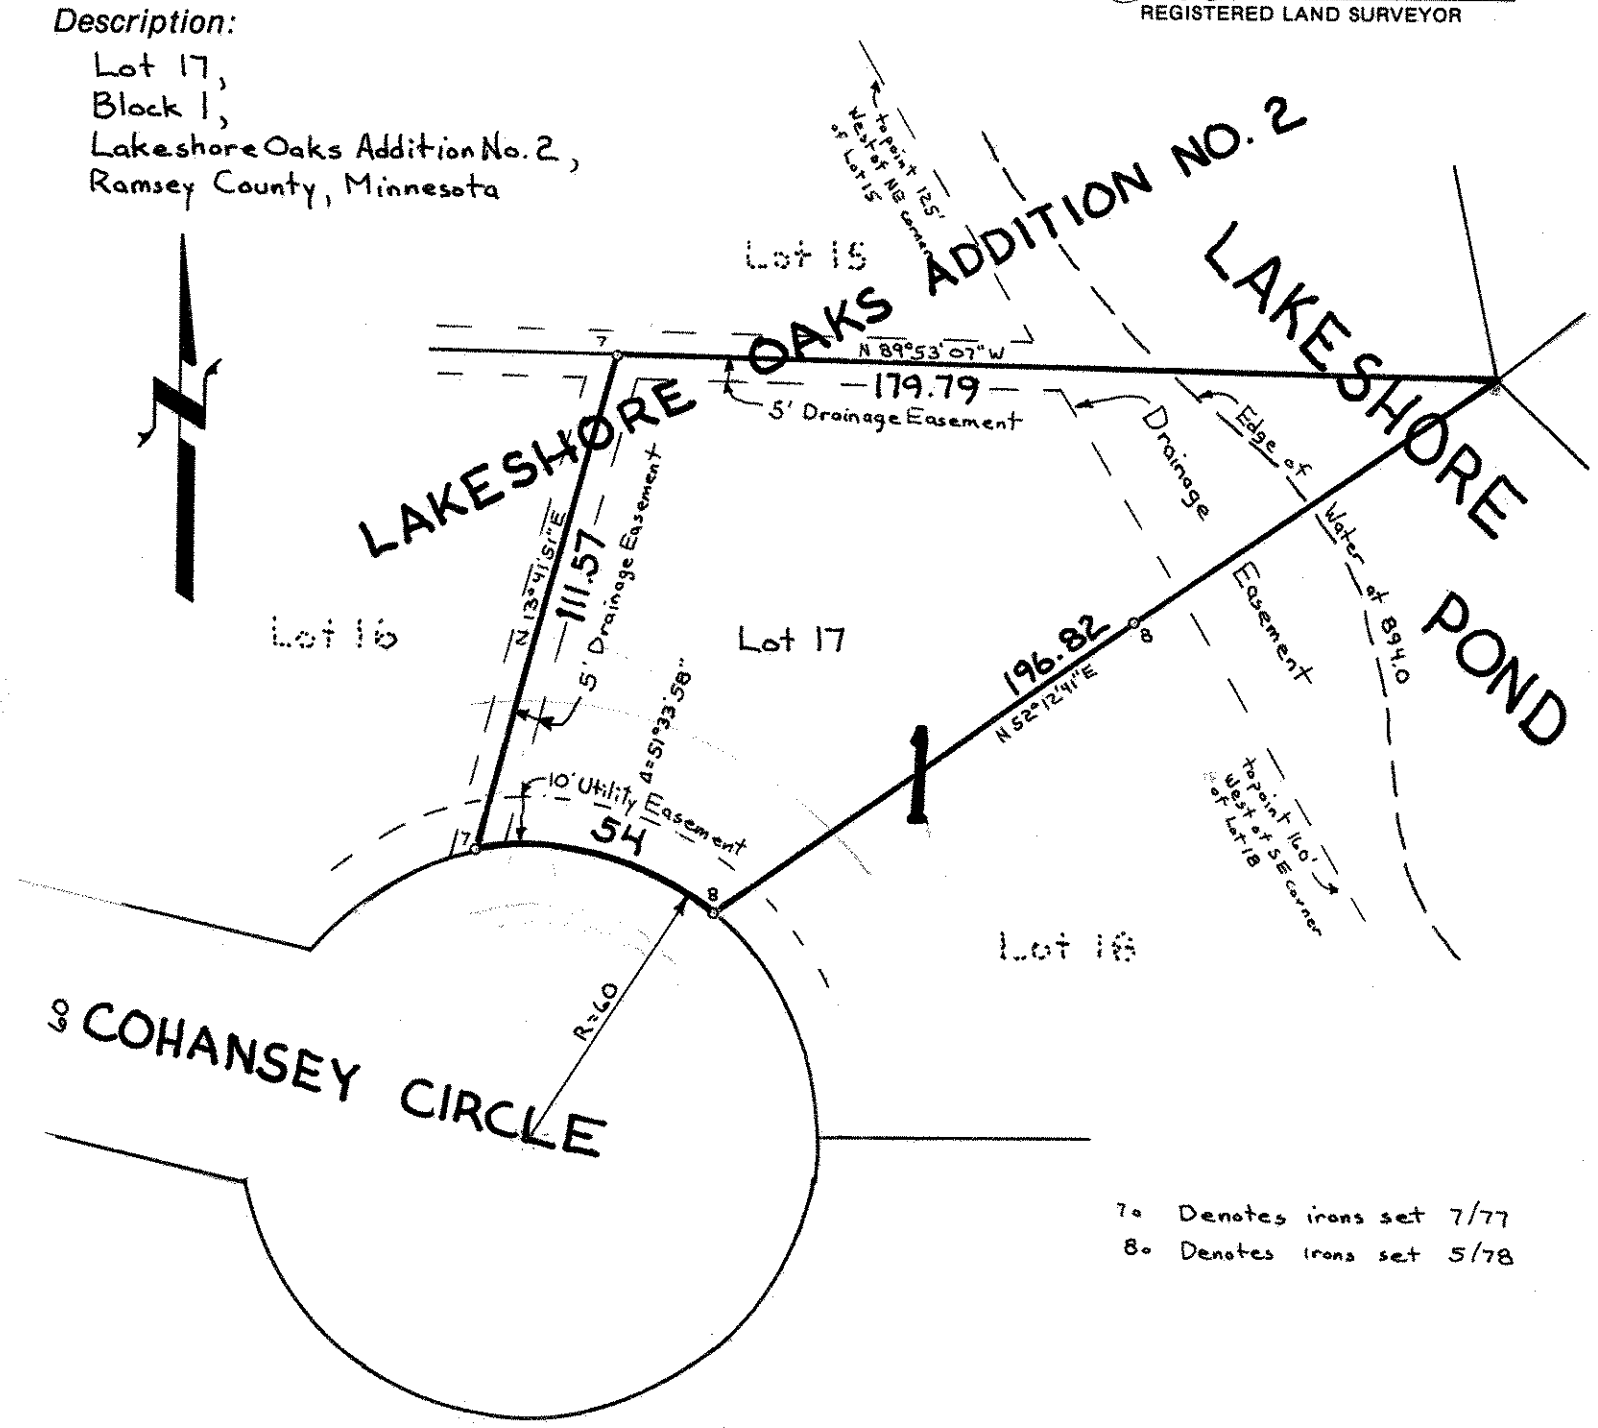

7∘ Denotes irons set 7/77

8∘ Denotes irons set 5/78