NE 30-30 23

FROM THE OFFICE OF

CHARLES O. GEORGI COMPANY

2215 West County Road B Saint Paul, Minnesota 55113

REGISTERED CIVIL ENGINEER AND LAND SURVEYOR

Certificate of Survey

I Hereby Certify that **this plat shows a survey made by me of the property described on this plat, and that the corners are correctly placed as shown, and that all locations have been correctly shown.**

Surveyed For Terry L. Roe

Date August 1976

Scale 1" = 40'

By Charles O. Georgi

REGISTERED LAND SURVEYOR

Description:
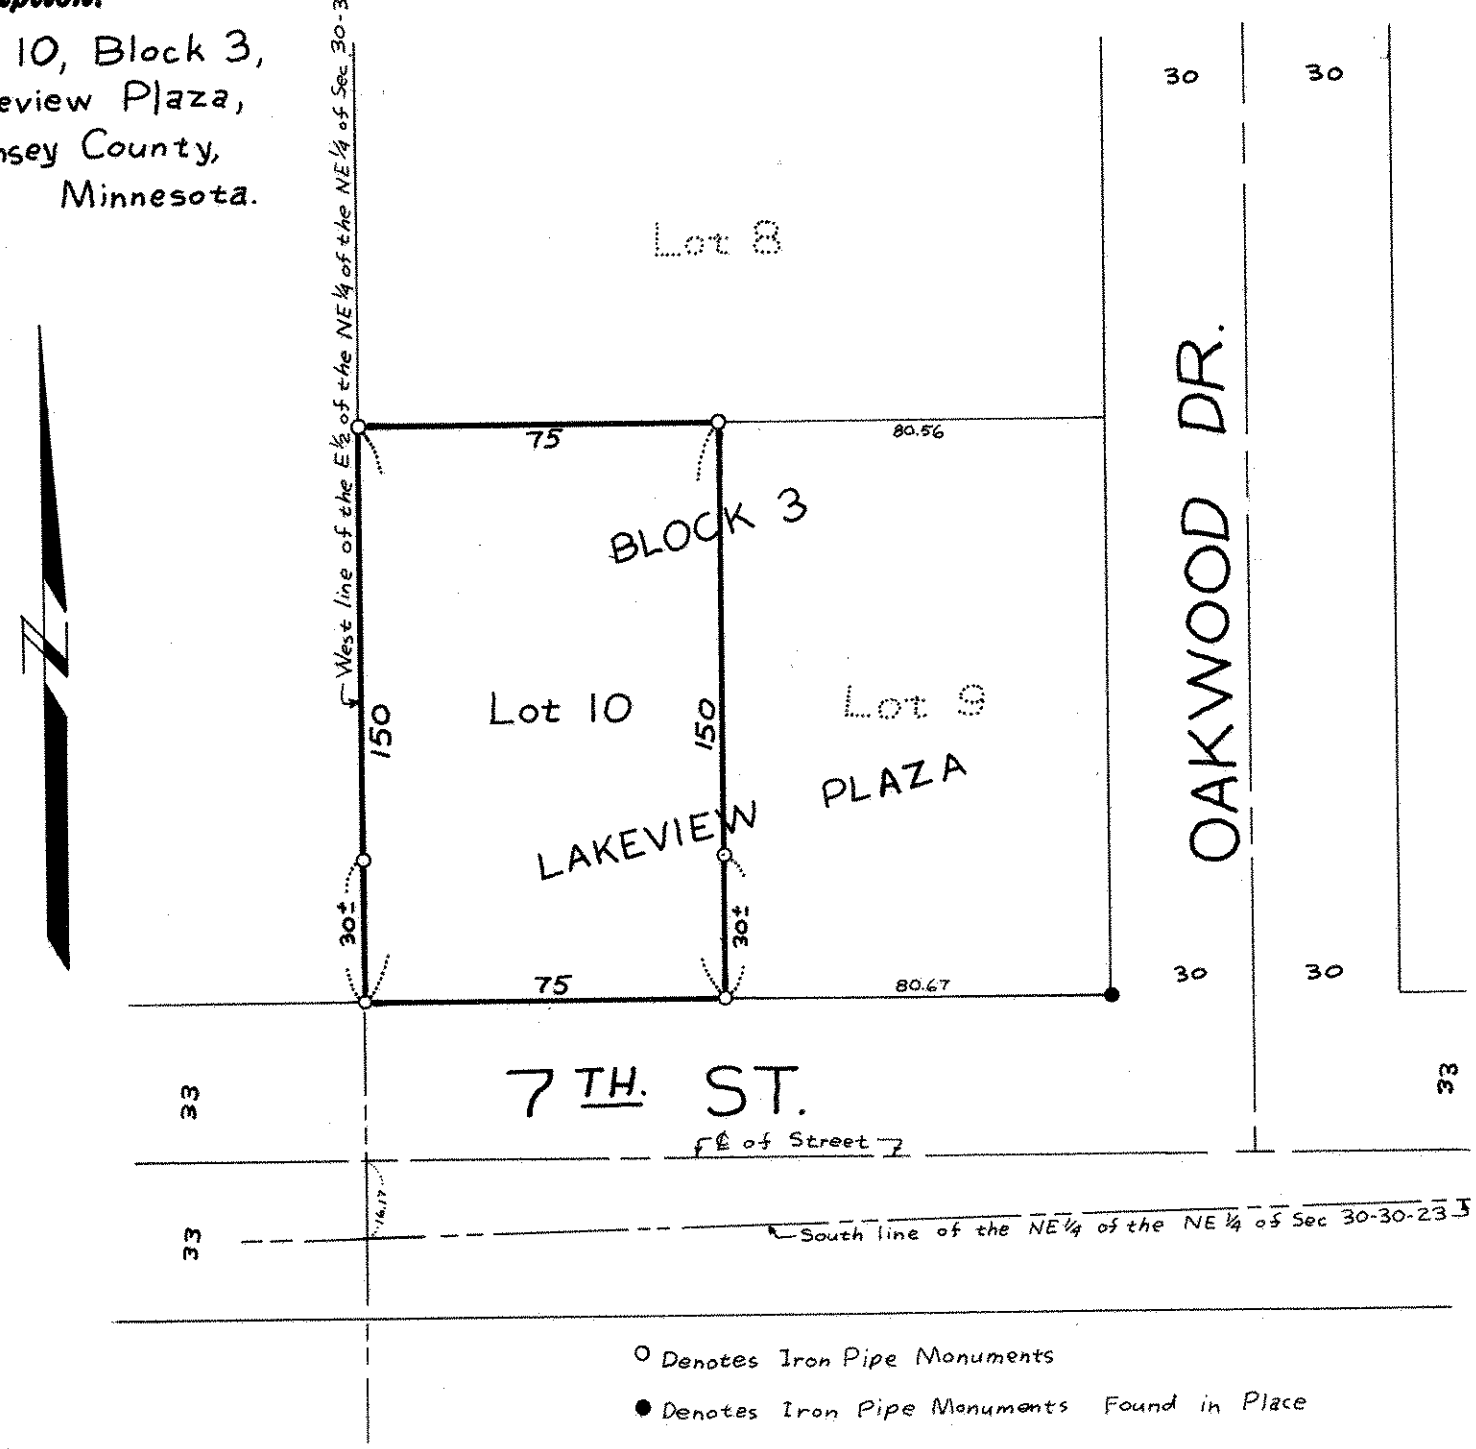
Lot 10, Block 3,
Lakeview Plaza,
Ramsey County,
Minnesota.