SE 21 30 23

Certificate of Survey

From the office of

GEORGI- SCHMIDT & ASSOC. INC.

3092 No. Lexington Ave., Roseville, Mn. 55113

LAND SURVEYING

483-4408

I Hereby Certify that this plat shows a survey made by me of the property described on this plat, and that the corners are correctly placed as shown,

Job Number: 1358

Surveyed For Belair Builders

Date April 7 1983

Scale 1" = 40'

By Donald W Schmidt

REGISTERED LAND SURVEYOR

#10459

Description: (as furnished)

Lot 5,
Block 1,
Janet Estates,
Ramsey County, Minn.

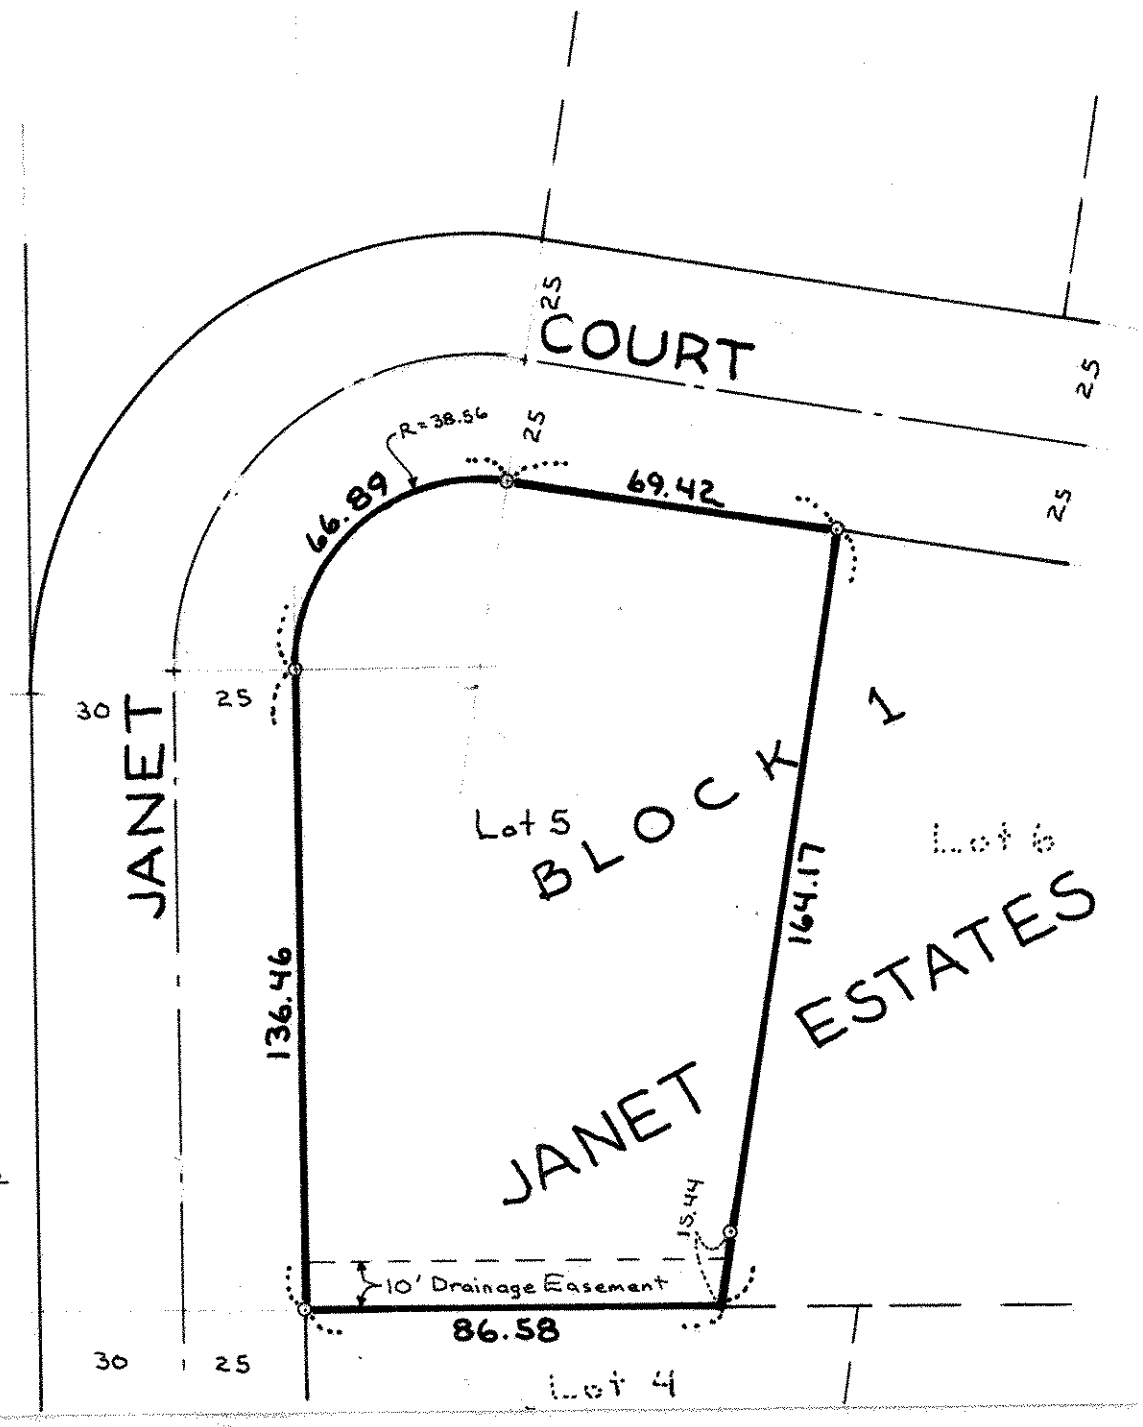

o Denotes Iron Pipe Monument

Easements as per plat only are shown