NE 23, 30, 23

Certificate of Survey

From the office of

GEORGI- SCHMIDT & ASSOC. INC.

3092 No. Lexington Ave., Roseville, Mn. 55113

LAND SURVEYING

483-4408

I Hereby Certify that this plat shows a survey made by me of the property described on this plat, and that the corners are correctly placed as shown, and that all locations have been correctly shown.

Job Number: 860

Surveyed For Wally Bauer Const

Date Feb 11, 1981

Scale 1" = 40'

By Ronald W. Schmidt

REGISTERED LAND SURVEYOR

Description:
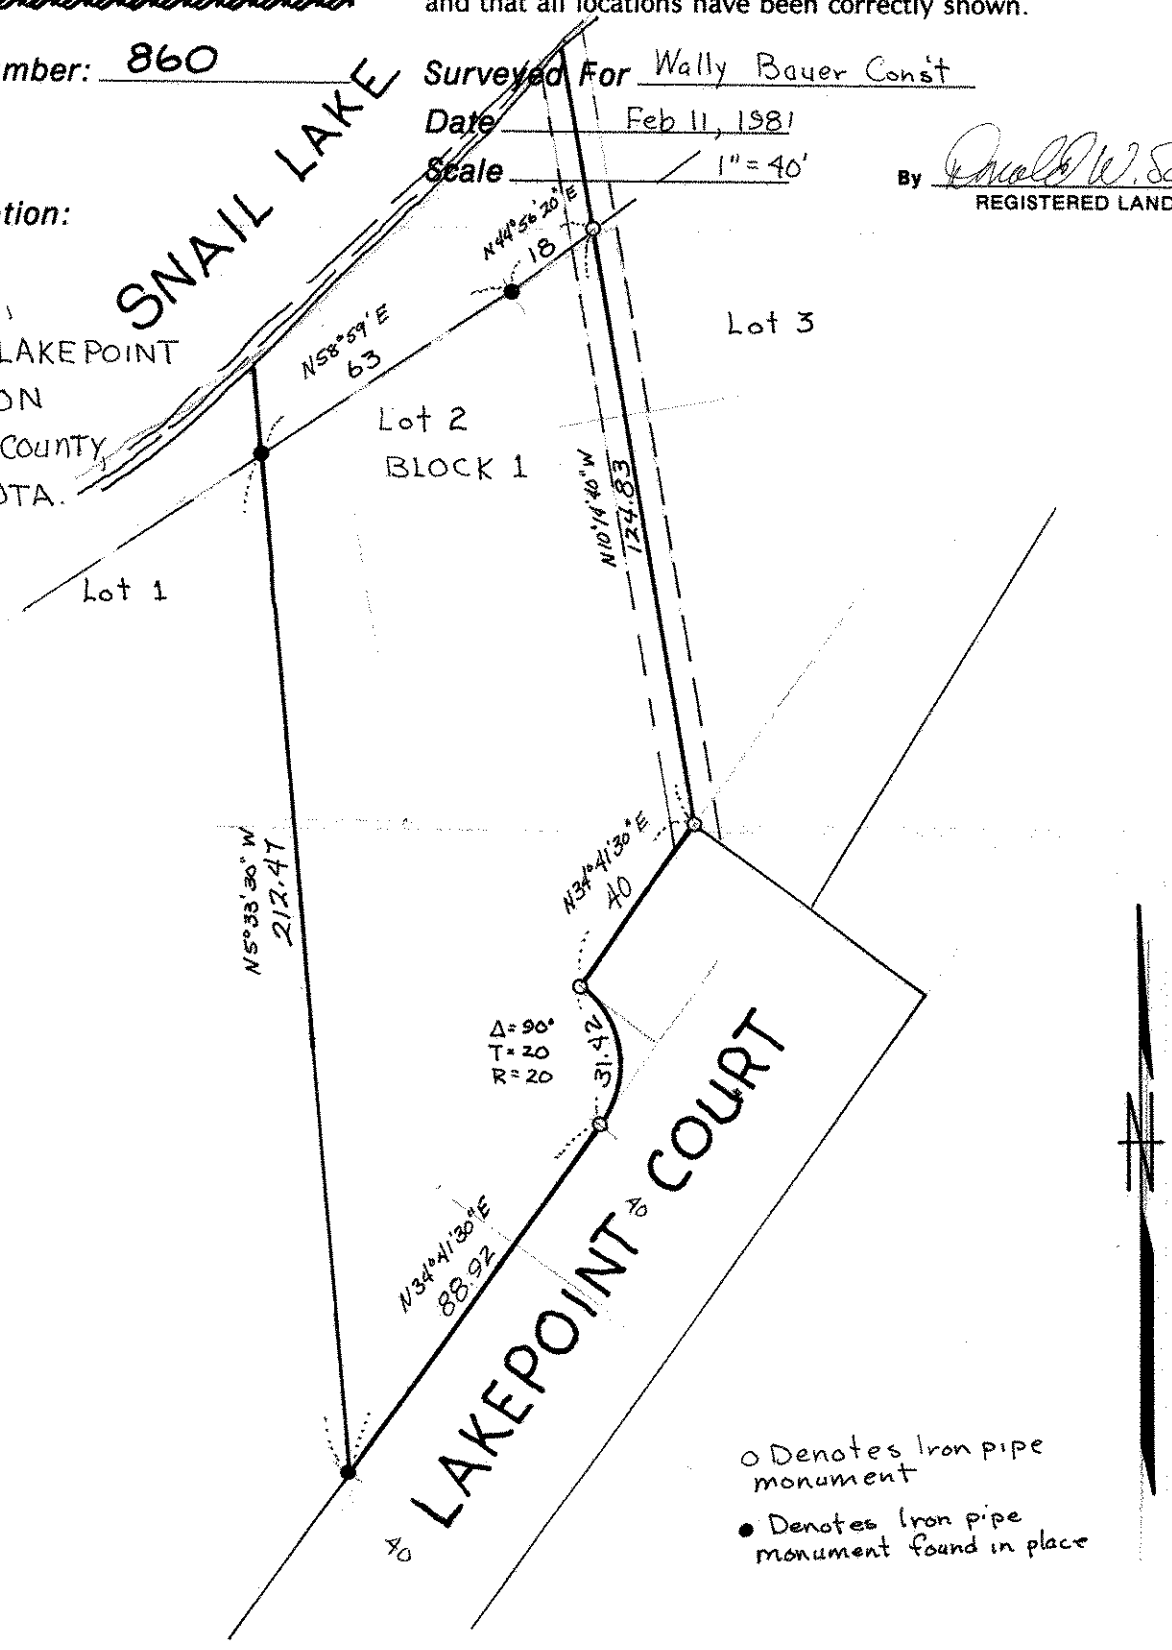
Lot 2,
BLOCK 1,
POHL'S LAKEPOINT
ADDITION
RAMSEY COUNTY
MINNESOTA.