

# Certificate of Survey

From the office of  
**GEORGI-SCHMIDT & ASSOC. INC.**

3092 No. Lexington Ave., Roseville, Mn. 55113

LAND SURVEYING

483-4408

I Hereby Certify that this plat shows a survey made by me of the property described on this plat, and that the corners are correctly placed as shown, and that all locations have been correctly shown.

Job Number: 439

Surveyed For Gerald Brock

Date August 16, 1979


Scale 1" = 40'

By Donald W. Schmidt  
REGISTERED LAND SURVEYOR

**Description:**

Lot 11, Block 10, Shorewood Hills No. 2

Ramsay County, Minnesota

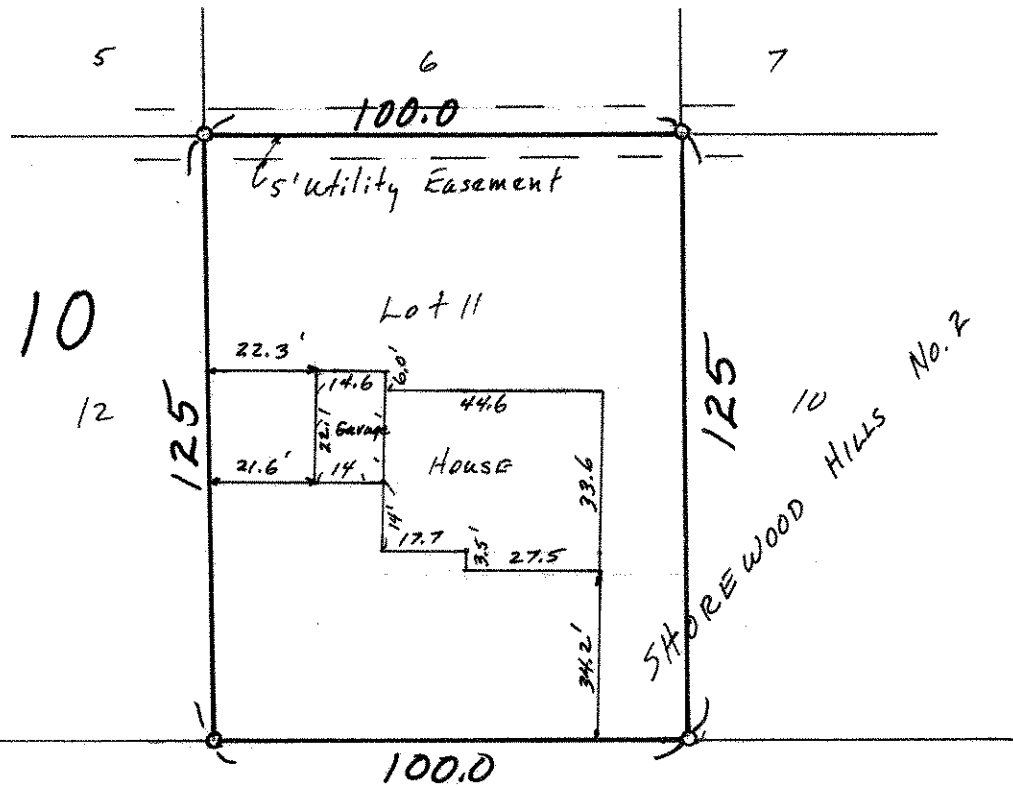

o Denotes Iron Monument

60 GLENVIEW AVE. 60