SE 27 30 23

FROM THE OFFICE OF

CHARLES O. GEORGI COMPANY

2215 West County Road B Saint Paul, Minnesota 55113

REGISTERED CIVIL ENGINEER AND LAND SURVEYOR

Certificate of Survey

I Hereby Certify that **this plat shows a survey made by me of the property described on this plat, and that the corners are correctly placed as shown, and that all locations have been correctly shown.**

Surveyed For Bennett Goldberg

Date February 1974

Scale 1" = 50'

By Charles O. Georgi
REGISTERED LAND SURVEYOR

Description:
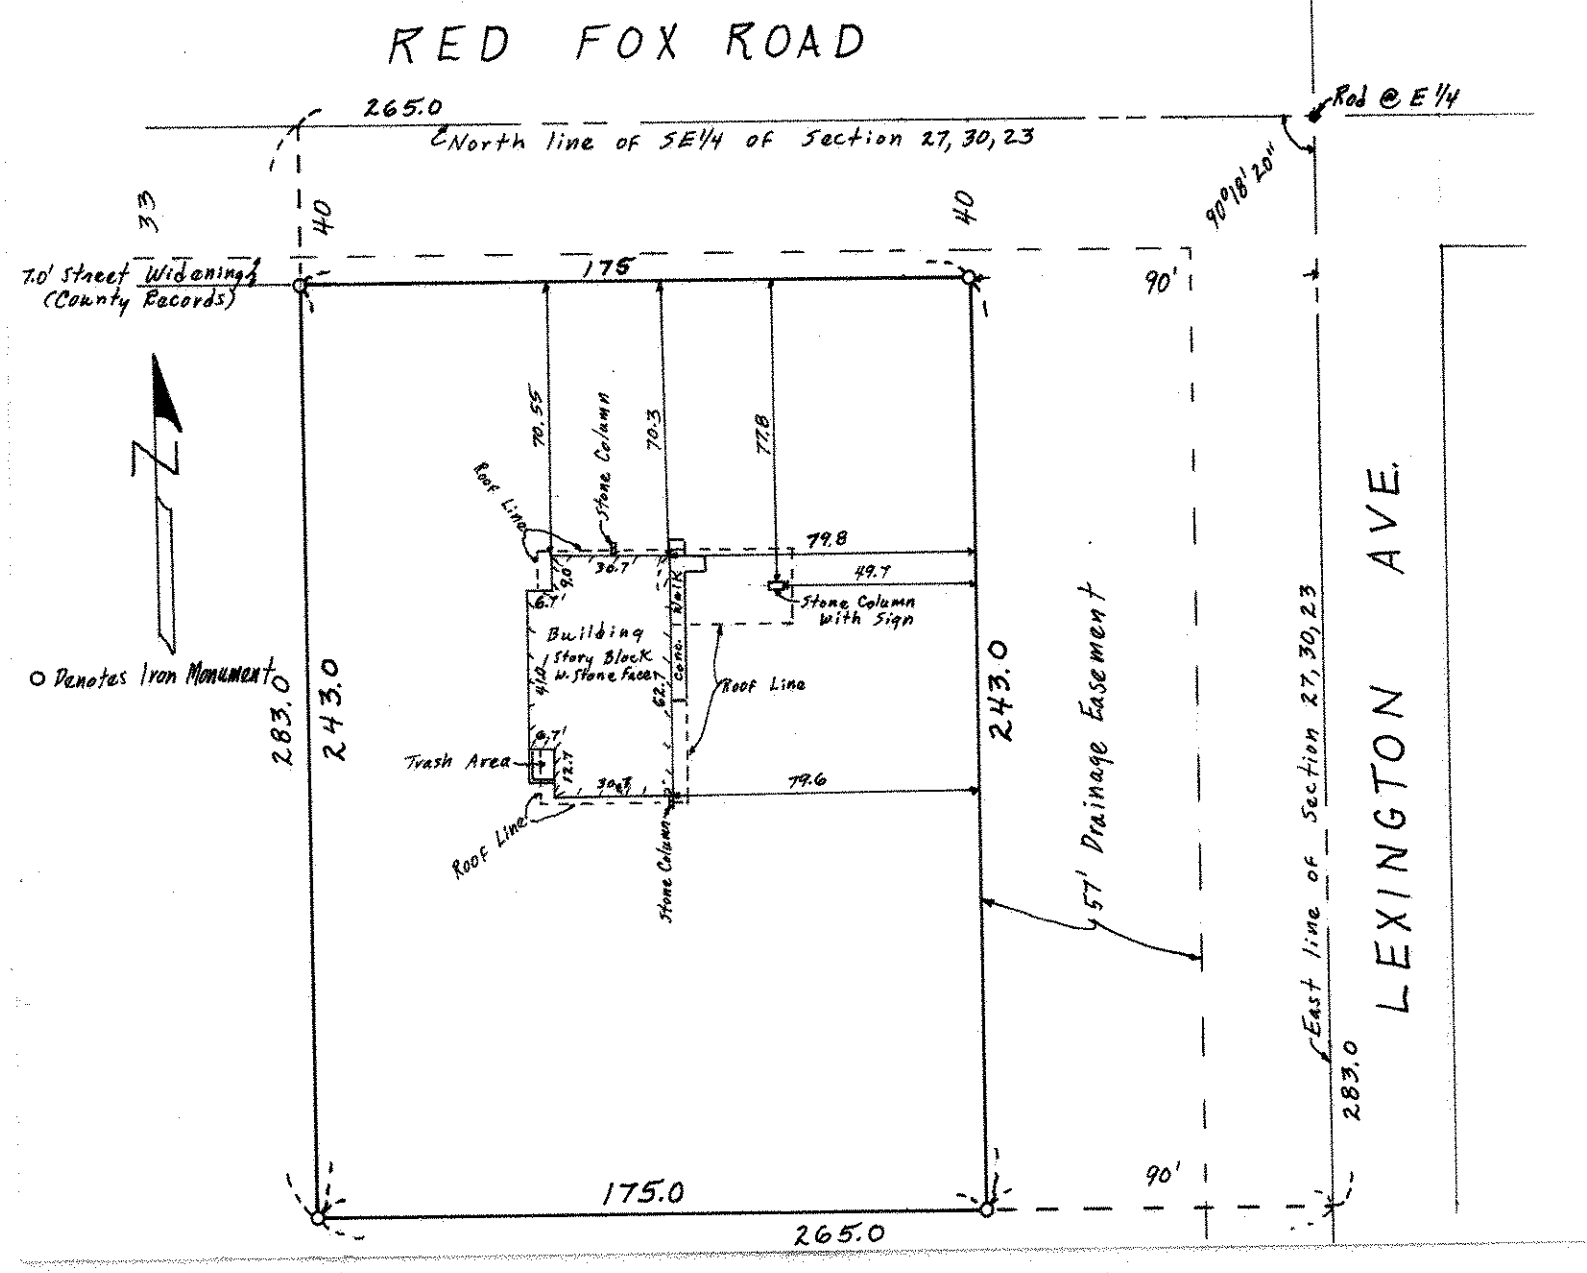
The East 265.0 feet of the North 283 feet of the SE¼ of Section 27, T 30 N, R 23 W.
Subject to Red Fox Road and Lexington Ave., and Subject to a drainage easement over the West 57 feet of the East 90 feet thereof.
Ramsey County, Minnesota