


From
Valentine Lake View

Bolt in mont.
Can be dipped.

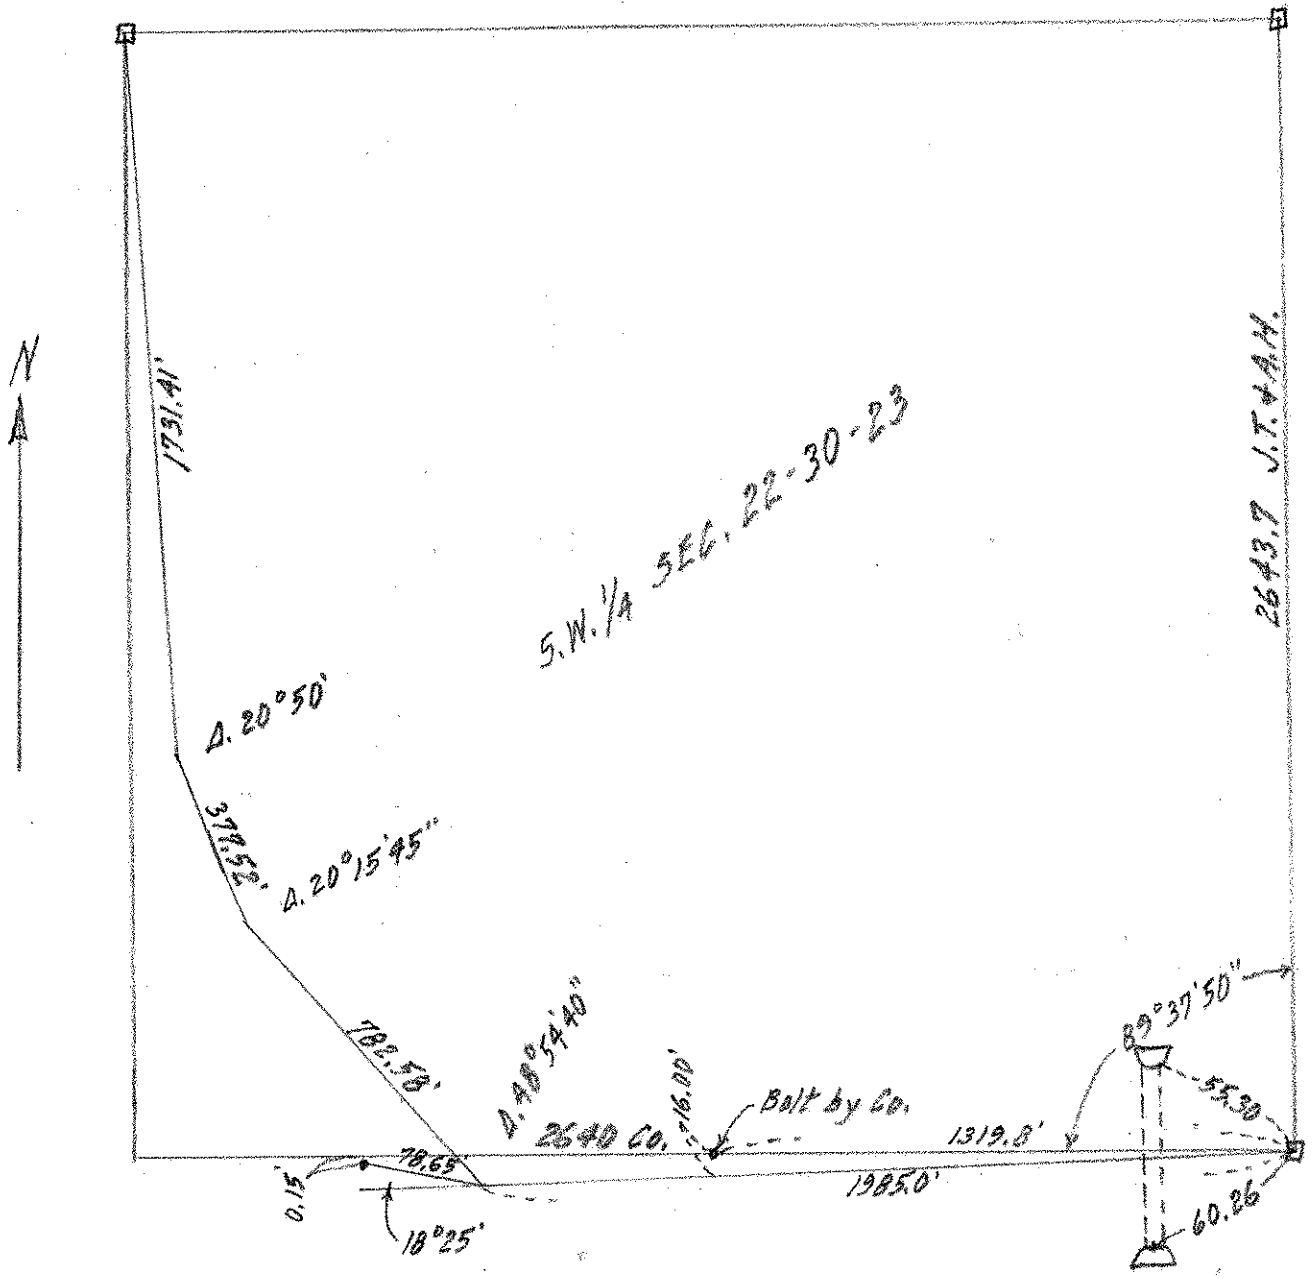

+ cuts in ends conc. culv