Certificate of Survey

From the office of
GEORGI- SCHMIDT & ASSOC. INC.
3092 No. Lexington Ave., Roseville, Mn. 55113
LAND SURVEYING
483-4408

I Hereby Certify that this plat shows a survey made by me of the property described on this plat, and that the corners are correctly placed as shown, and that all locations have been correctly shown.

Job Number: 344
Surveyed For Clint Carlson
Date July 30, 1979
Scale 1" = 100'

By Donald W. Schmidt
REGISTERED LAND SURVEYOR

DESCRIPTION (Total)

The West 150 feet of the East 225 feet of the North ½ of the North ½ of the Southwest ¼ of the Southeast ¼ of Section 18, T30N, R23W, subject to Rice Creek Road

Ramsey County, Minnesota

Parcel 1:

The West 75 feet of the East 225 feet of the North ½ of the North ½ of the Southwest ¼ of the Southeast ¼ of Section 18, T30N, R23W. Subject to Rice Creek Road.

Parcel 2:
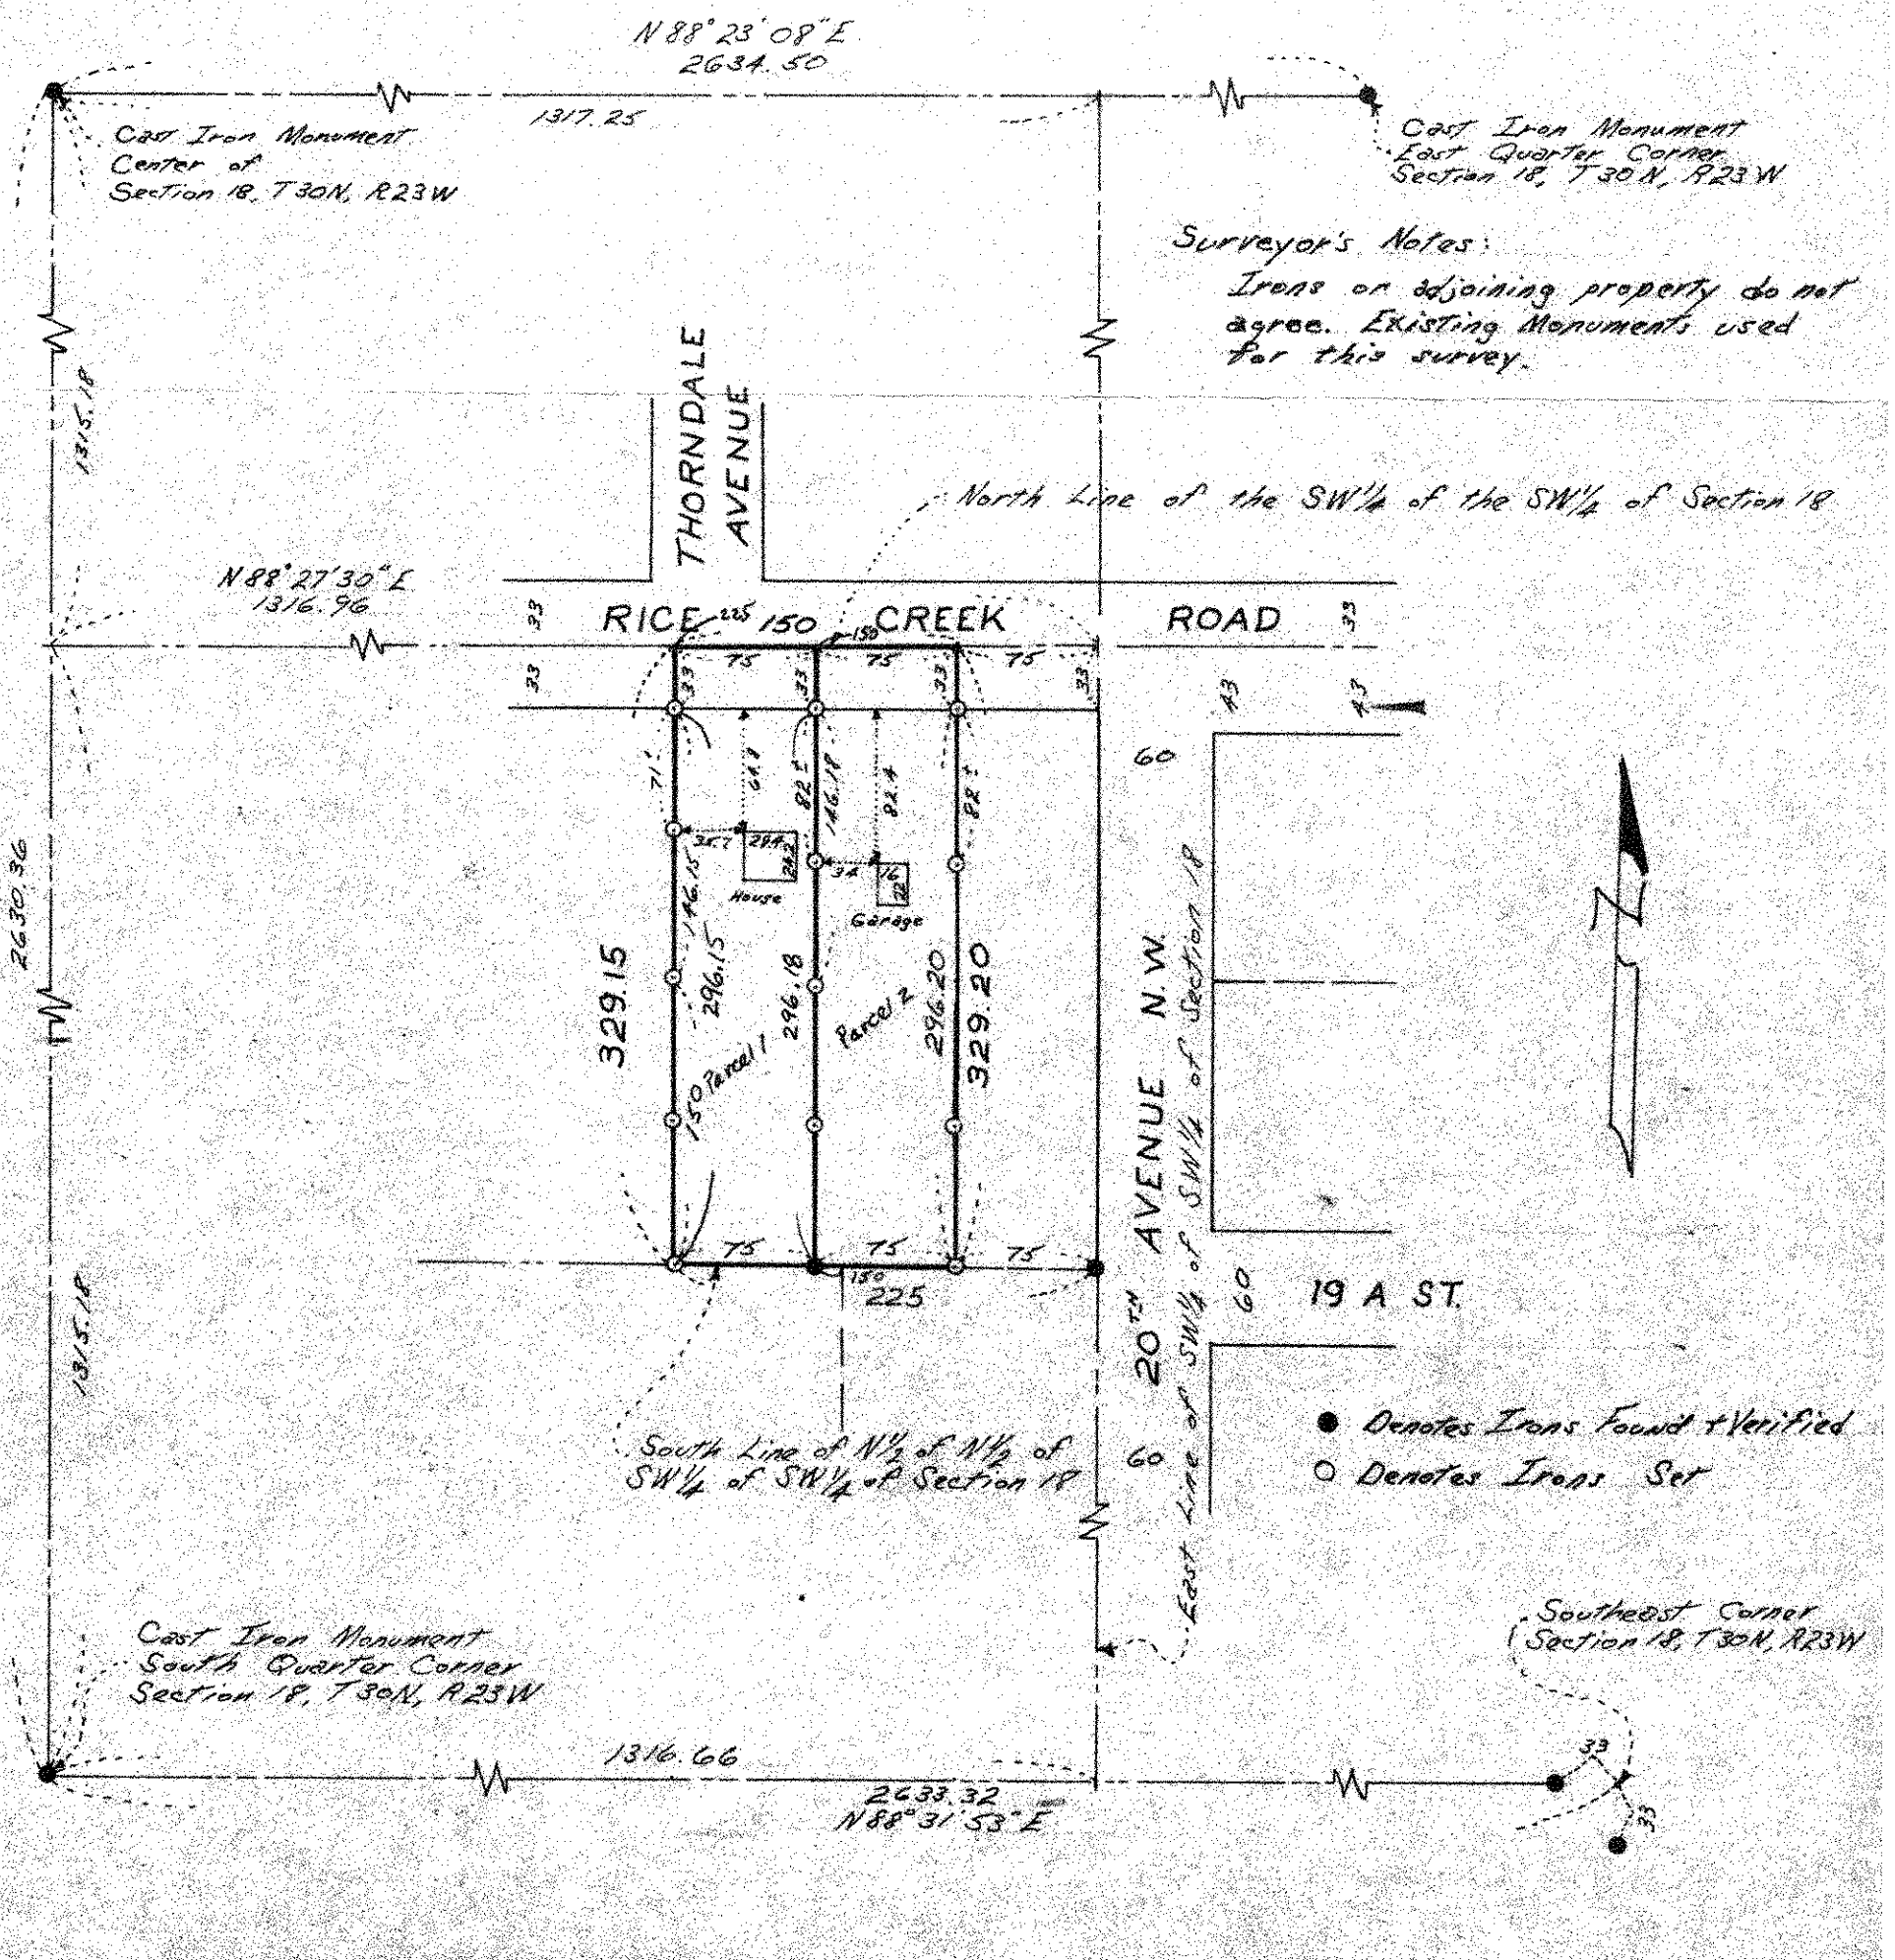
The West 75 feet of the East 150 feet of the North ½ of the North ½ of the Southwest ¼ of the Southeast ¼ of Section 18, T30N, R23W. Subject to Rice Creek Road.