

NW 23 30 23

Certificate of Survey

From the office of
GEORGI-SCHMIDT & ASSOC. INC.
3092 No. Lexington Ave., Roseville, Mn. 55113
LAND SURVEYING
483-4408

I Hereby Certify that this plat shows a survey made by me of the property described on this plat, and that the corners are correctly placed as shown, and that all locations have been correctly shown.

Job Number: 816

Surveyed For Don Ziball

Date 5/21/82


Scale 1" = 50'

By Arnold W. Schmidt
REGISTERED LAND SURVEYOR

Description:

Lot 4, Block 1, VICTORIA HILLS No. 3

RAMSEY COUNTY, MN.

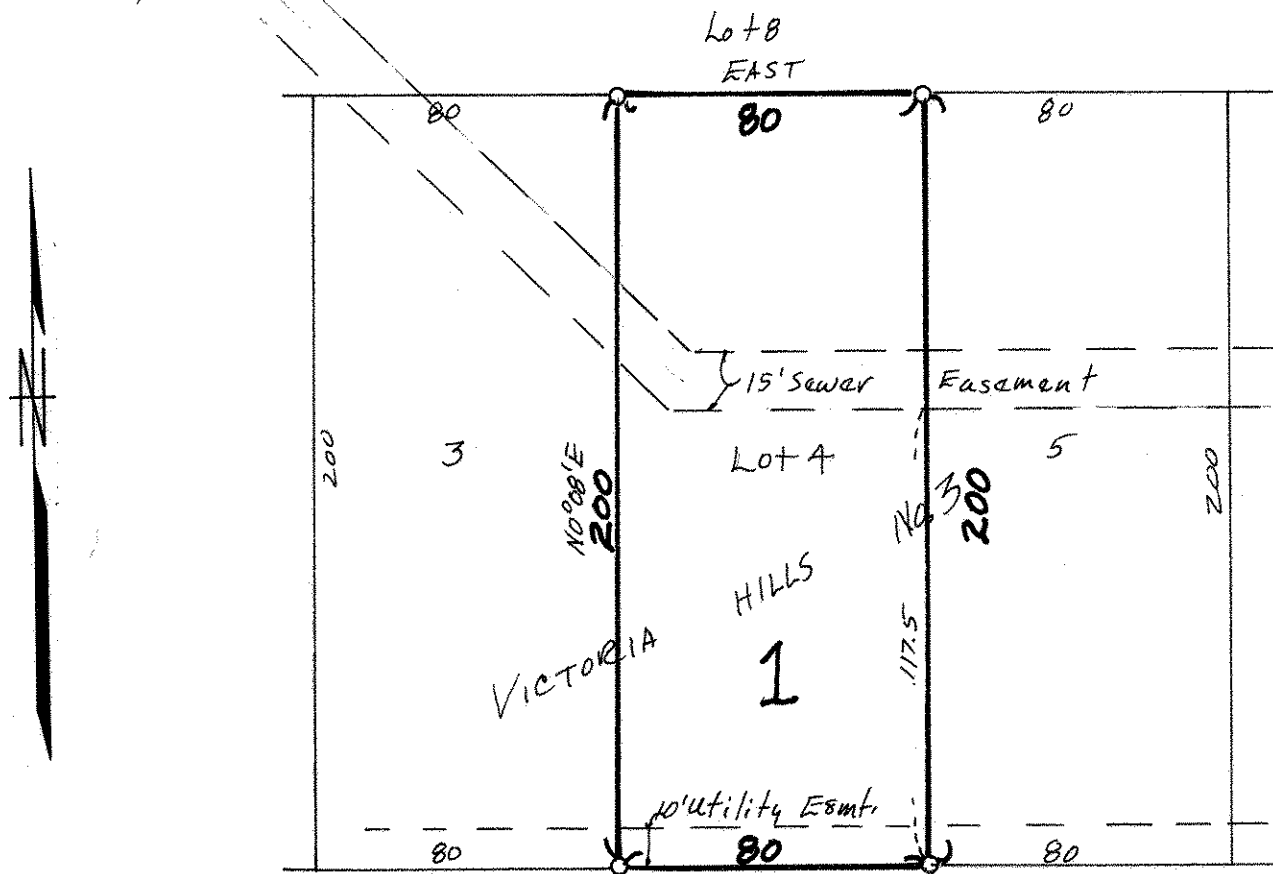

○ Denotes Iron Pipe Monument

AMBLE ROAD