

NW 23 30 23

**Certificate  
of Survey**

From the office of  
**GEORGI-SCHMIDT & ASSOC. INC.**  
3092 No. Lexington Ave., Roseville, Mn. 55113  
LAND SURVEYING  
483-4408

I Hereby Certify that this plat shows a survey made by me of the property described on this plat, and that the corners are correctly placed as shown, and that all locations have been correctly shown.

Job Number: 816

Surveyed For Don Ziball

Date 5/21/82


Scale 1" = 50'

By Donald W. Schmidt  
REGISTERED LAND SURVEYOR

**Description:**

Lot 2, Block 1, Victoria Hills No. 3

Ramsay County, Mn.

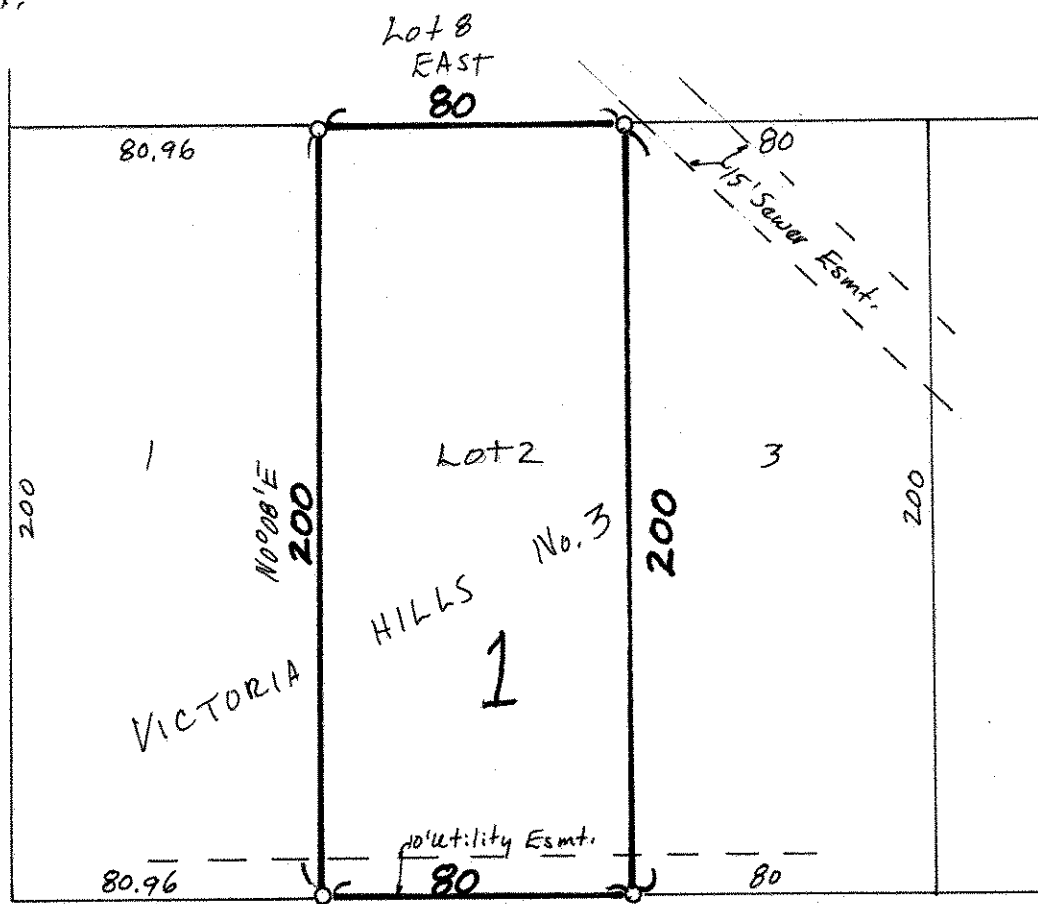

o Denotes Iron Pipe Monument

2

AMBLER ROAD

70