


FROM THE OFFICE OF

**CHARLES O. GEORGI COMPANY**

2215 West County Road B

Saint Paul 13, Minnesota

REGISTERED CIVIL ENGINEER AND LAND SURVEYOR



**Certificate  
of Survey**

*I Hereby Certify that this plat shows a survey made by me of the property described on this plat, and that the corners are correctly placed as shown, and that all locations have been correctly shown.*

Surveyed For *Louis F. Keller Jr*

Date *July 1960*

Scale *1" = 100'*


By *Charles O. Georgi*  
REGISTERED LAND SURVEYOR

## Description:

Lot 7

Block 4

SHOREWOOD HILLS

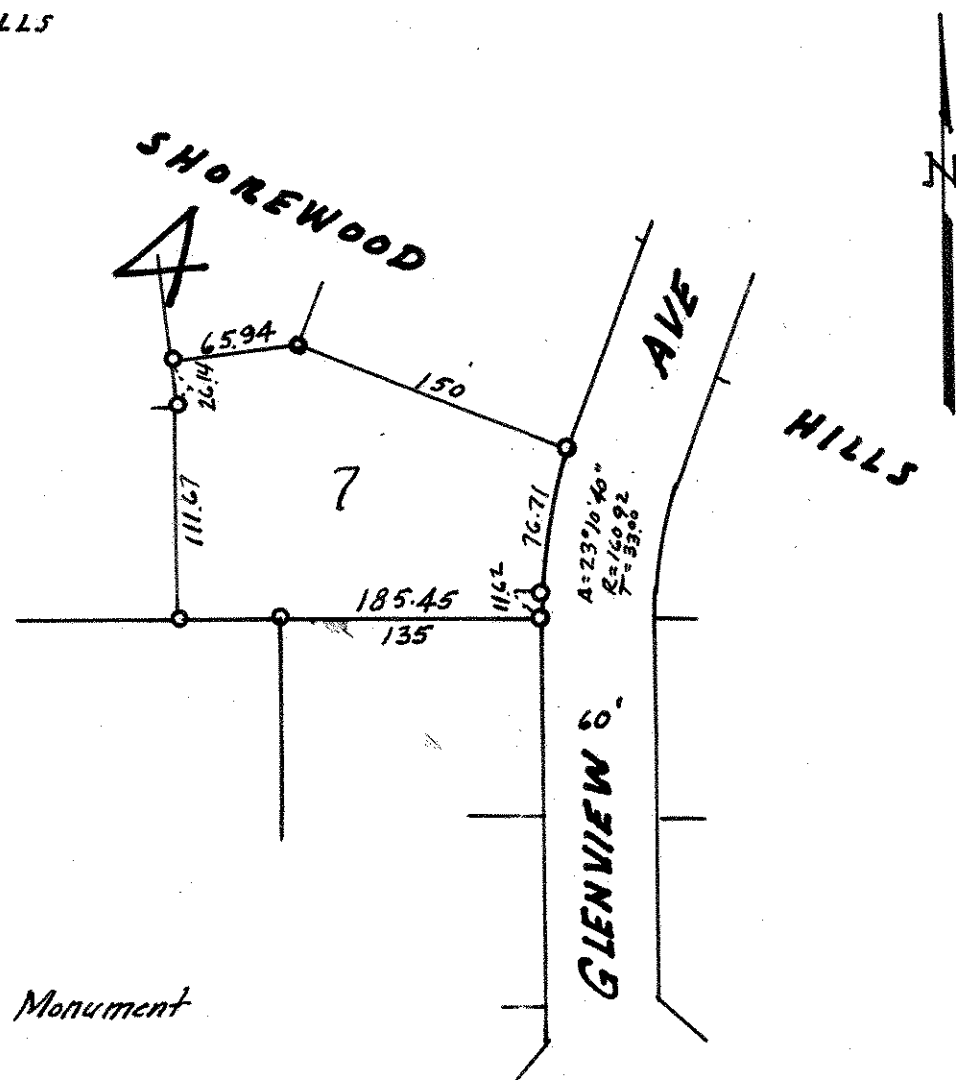

○ Denotes Iron Monument