


DIETZEN NO. 384-B

↑ Ridgeport


Lot 1-BK 7

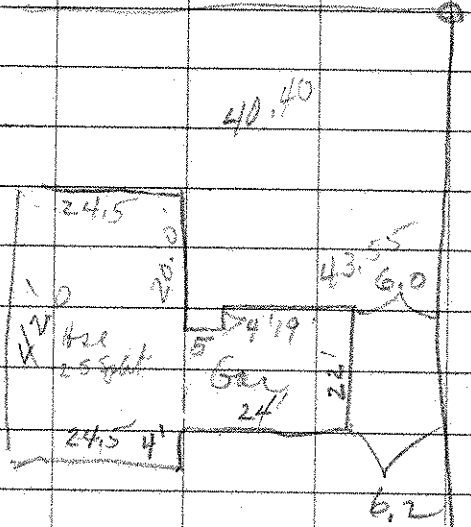

Lot 2 Block 12 RIDGEGATE



DIETZEN NO. 384-B

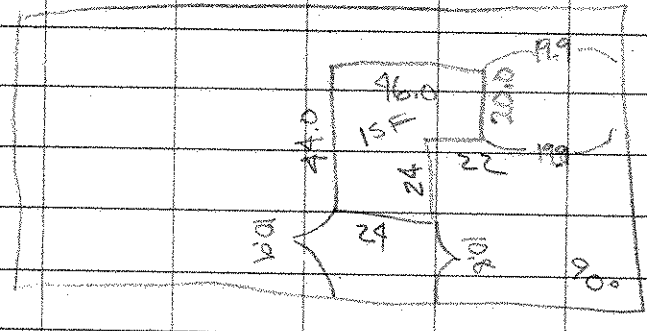

CAVENDISH