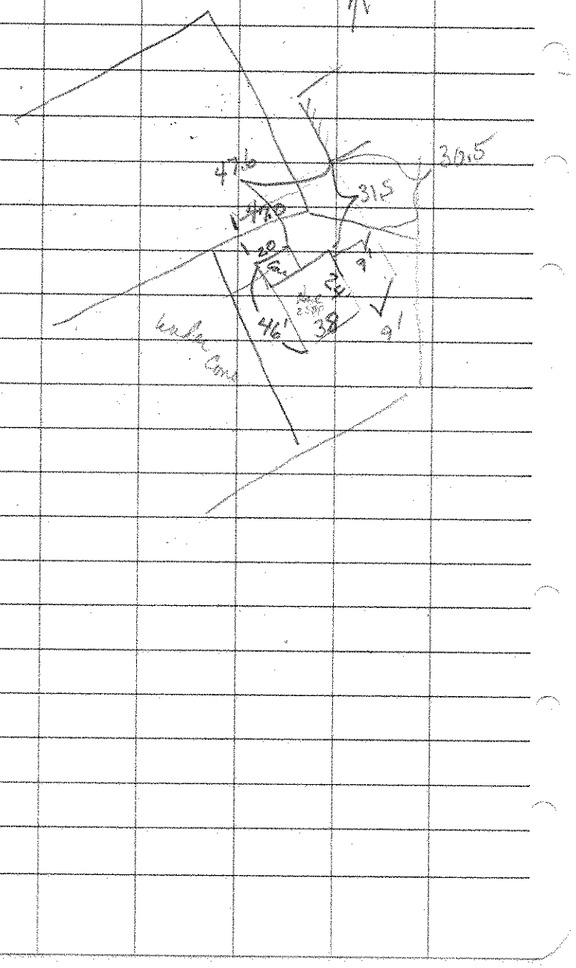Lot 16 - BK 20