

NE. 17, 28, 21

Certificate  
of Survey

From the office of  
**GEORGI-SCHMIDT & ASSOC. INC.**  
3092 No. Lexington Ave., Roseville, Mn. 55113  
LAND SURVEYING  
483-4408

I Hereby Certify that this plat shows a survey made by me of the property described on this plat, and that the corners are correctly placed as shown, and that all locations have been correctly shown.

Job Number: 236

Surveyed For Ted Glasrud Assoc


Date January 1979

Scale 1"=20'

By Donald W Schmidt  
REGISTERED LAND SURVEYOR

Description:  
Lot 6,  
Block 14,  
Ridgegate  
Washington County,  
Minnesota.

CHYENNE PLAZA  
WEST

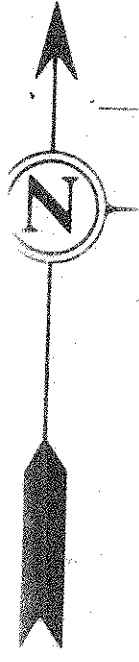

o Denotes iron  
pipe monument.  
● Denotes Iron Found

