

NE 17 28 21

Certificate of Survey

From the office of
GEORGI-SCHMIDT & ASSOC. INC.
3092 No. Lexington Ave., Roseville, Mn. 55113
LAND SURVEYING
483-4408

I Hereby Certify that this plat shows a survey made by me of the property described on this plat, and that the corners are correctly placed as shown, and that all locations have been correctly shown.

5/29/78 Added Hse Location DWS

Job Number: 35

Surveyed For GLASRUO ASSOC.


Date JUNE 1978

Scale 1" = 40'

By Donald W Schmidt
REGISTERED LAND SURVEYOR

Description:

Lot 6, Block 2 RIDGEGATE SECOND ADDITION
WASHINGTON Co., MINN.

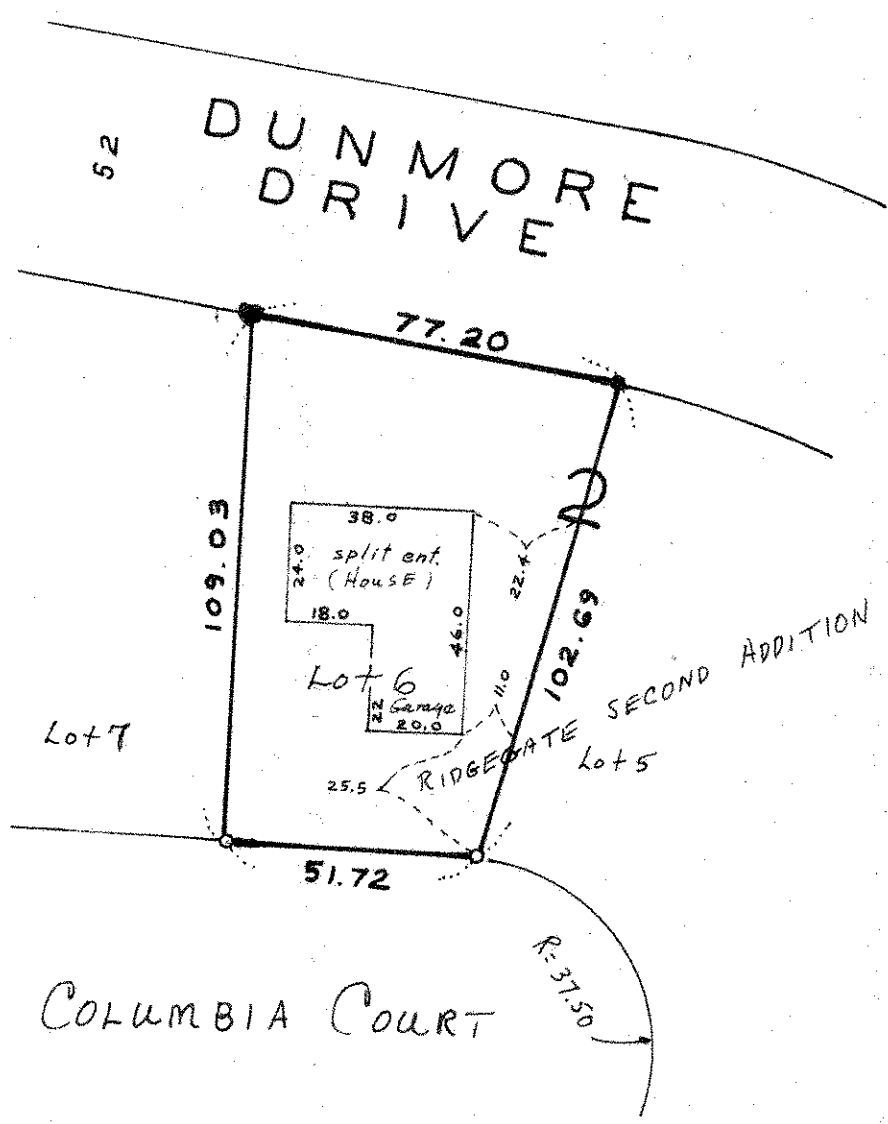

o Denotes Iron Monument
● Denotes Iron found in place