

NE 12 28 21

# Certificate of Survey

From the office of  
**GEORGI-SCHMIDT & ASSOC. INC.**  
3092 No. Lexington Ave., Roseville, Mn. 55113  
LAND SURVEYING  
483-4408

I Hereby Certify that this plat shows a survey made by me of the property described on this plat, and that the corners are correctly placed as shown, and that all locations have been correctly shown.

Job Number: 35

Surveyed For GLASRUO Assoc.


Date JUNE 1978

Scale 1" = 40'

By Donald W. Schmidt  
REGISTERED LAND SURVEYOR

Description:

Lot 6, Block 2 RIDGEGATE SECOND ADDITION  
WASHINGTON Co., MINN.

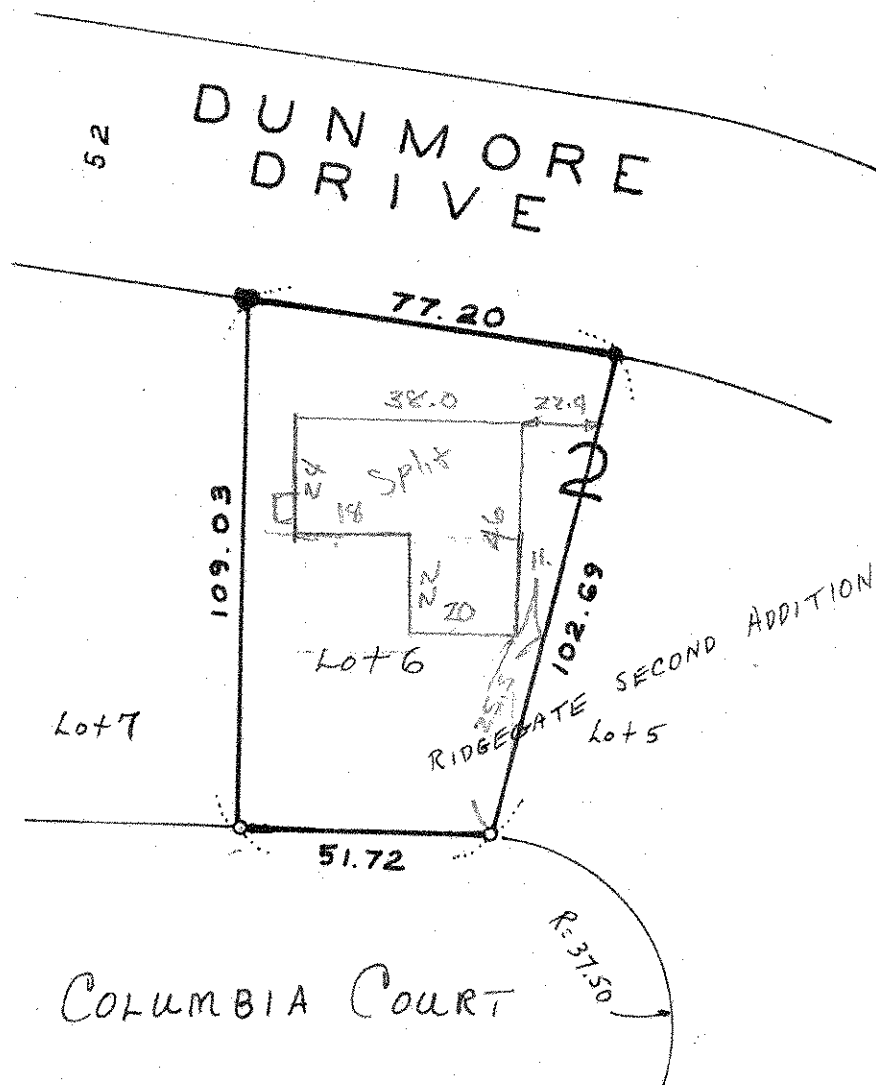

○ Denotes Iron Monument  
● Denotes Iron found in place