NE 17 28 21

Certificate of Survey

From the office of

GEORGI- SCHMIDT & ASSOC. INC.

3092 No. Lexington Ave., Roseville, Mn. 55113

LAND SURVEYING

483-4408

I Hereby Certify that this plat shows a survey made by me of the property described on this plat, and that the corners are correctly placed as shown, and that all locations have been correctly shown.

Job Number: 35

Surveyed For Glasrud Assoc.

Date June 1978

Scale 1"=40

By Donald W Schmidt

REGISTERED LAND SURVEYOR

Description:

Lot 7, Block 1, Ridgegate Second Addition
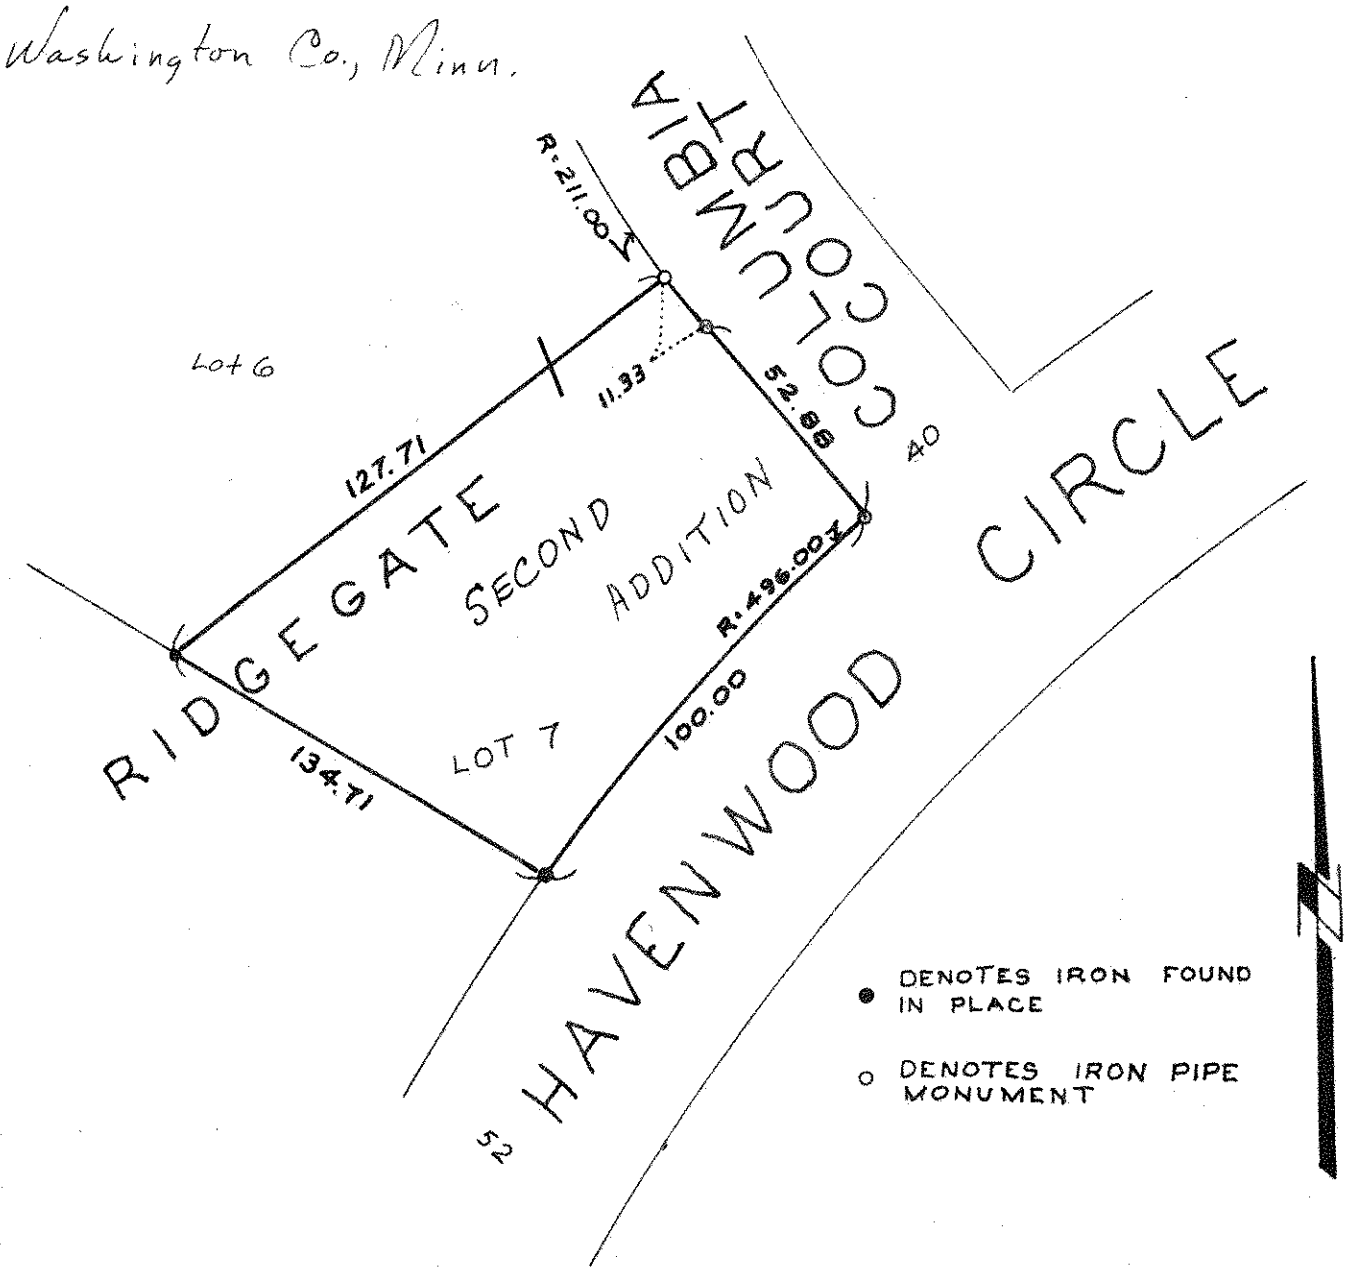
Washington Co., Minn.