

NE 17 28 21

**Certificate
of Survey**

From the office of
GEORGI-SCHMIDT & ASSOC. INC.
3092 No. Lexington Ave., Roseville, Mn. 55113
LAND SURVEYING
483-4408

I Hereby Certify that this plat shows a survey made by me of the property described on this plat, and that the corners are correctly placed as shown, and that all locations have been correctly shown.

Job Number: 62

Surveyed For GLASRUW Assoc.

Date AUG. 1978

Scale 1" = 20'


By Arnold W. Schmidt
REGISTERED LAND SURVEYOR

Description:

Lot A, Block 1

RIDGEGATE SECOND ADD.

WASHINGTON Co., MINN

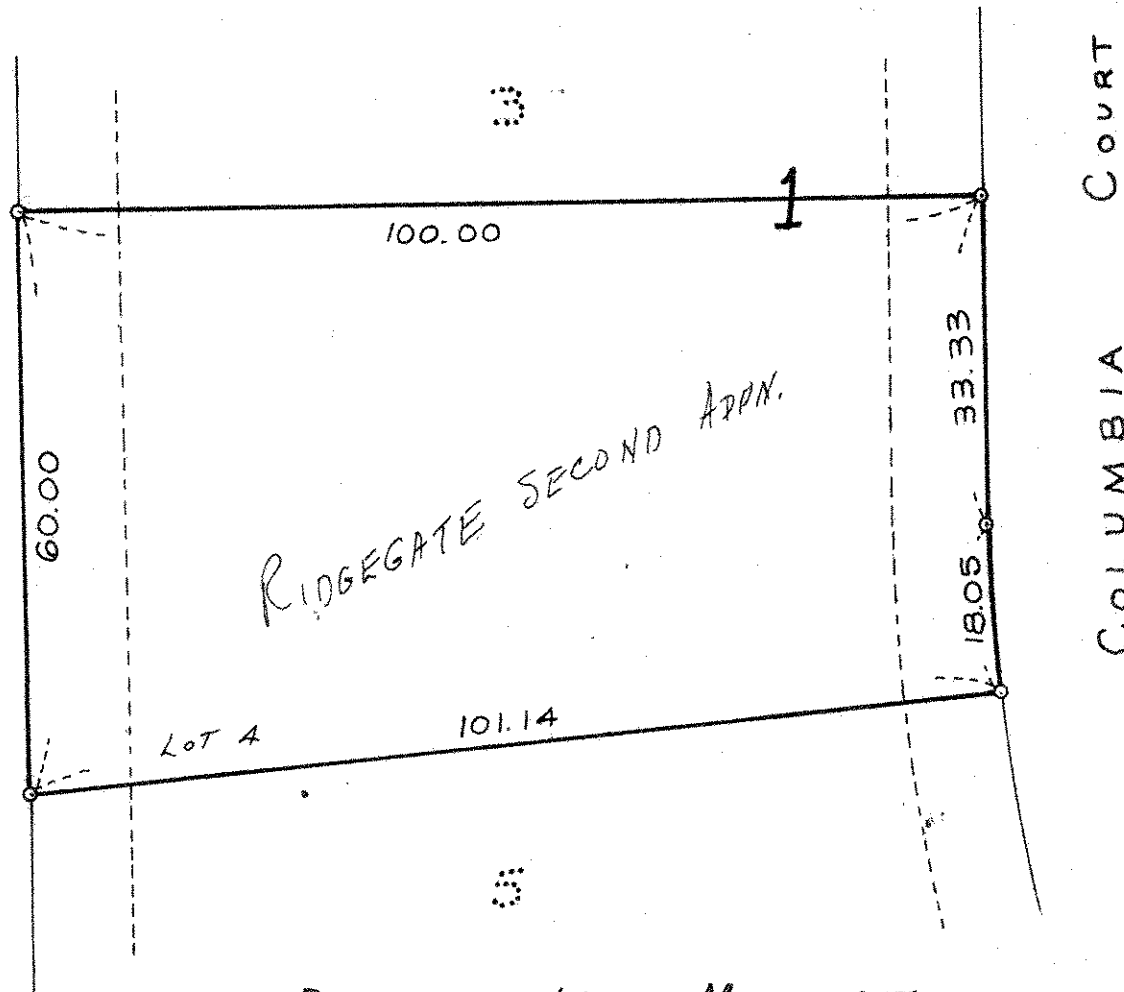

o DENOTES IRON MONUMENT