

FROM THE OFFICE OF

CHARLES O. GEORGI COMPANY

2215 West County Road B

Saint Paul, Minnesota 55113

REGISTERED CIVIL ENGINEER AND LAND SURVEYOR

Certificate of Survey

I Herby Certify that this plat shows a survey made by me of the property described on this plat, and that the corners are correctly placed as shown, and that all locations have been correctly shown.

Building Location 9-28-77 C.O.G.

Surveyed For Ted Glasrud Assoc.


Date July 1977

Scale 1"=20'

By Charles O. Georgi
REGISTERED LAND SURVEYOR

Description:

Lot 4,
Block 5,
Ridgegate Patio Homes,
Washington County,
Minnesota.

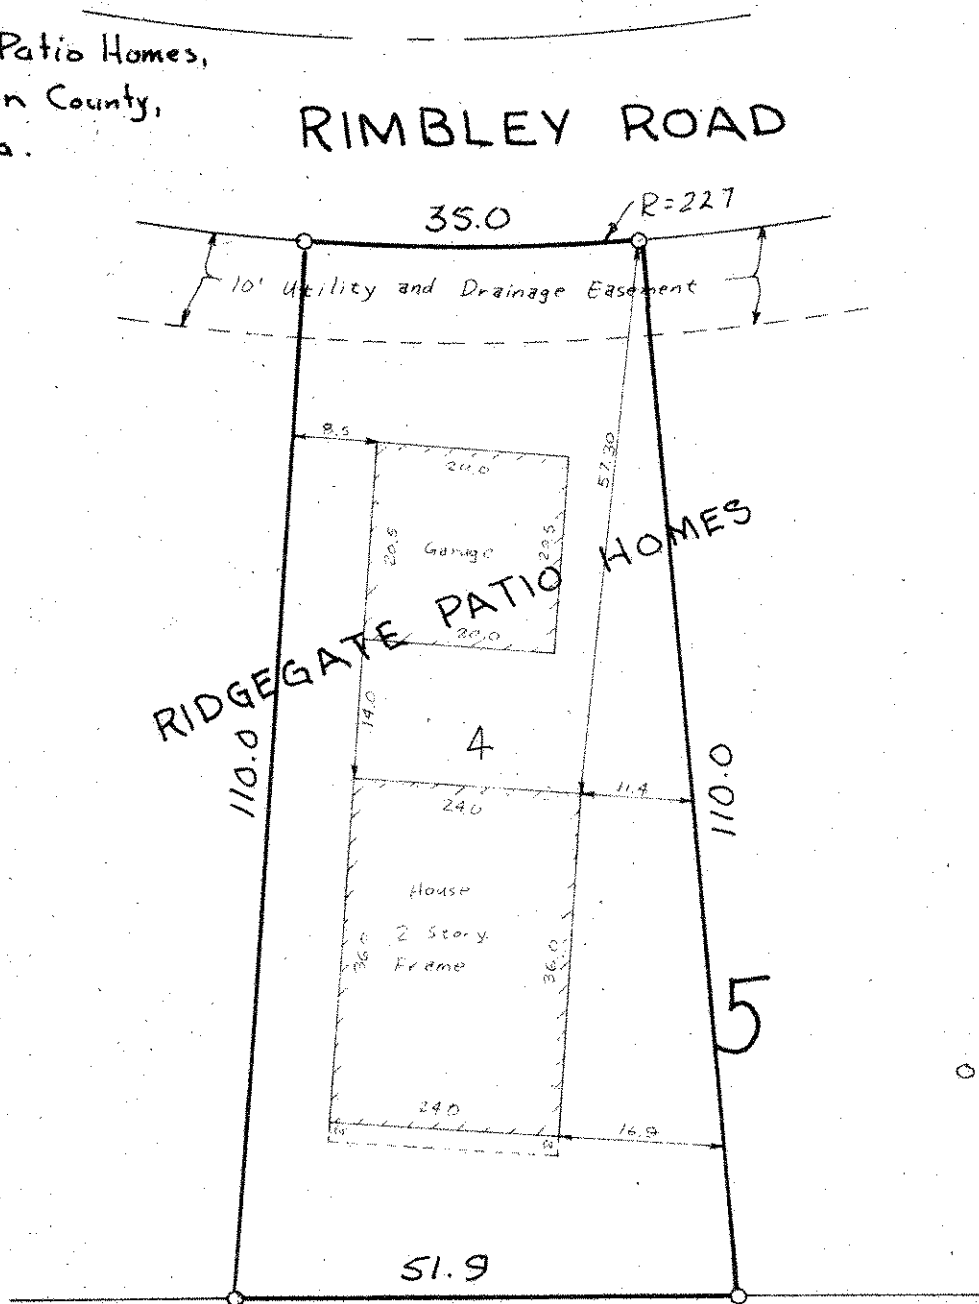

o Denotes iron pipe monument.