NE 17 28 21

Certificate of Survey

FROM THE OFFICE OF

CHARLES O. GEORGI COMPANY

2215 West County Road B Saint Paul, Minnesota 55113

REGISTERED CIVIL ENGINEER AND LAND SURVEYOR

I Hereby Certify that this plat shows a survey made by me of the property described on this plat, and that the corners are correctly placed as shown, and that all locations have been correctly shown.

4/18/78 Added House Loc. DWS

Surveyed For Ted Glasrud

Date Nov. 1977

Scale 1" = 20'

By Donald W Schmidt
REGISTERED LAND SURVEYOR

Description:
Lot 3, Block 5,
Ridgegate Patio Homes,
Washington County,
Minnesota

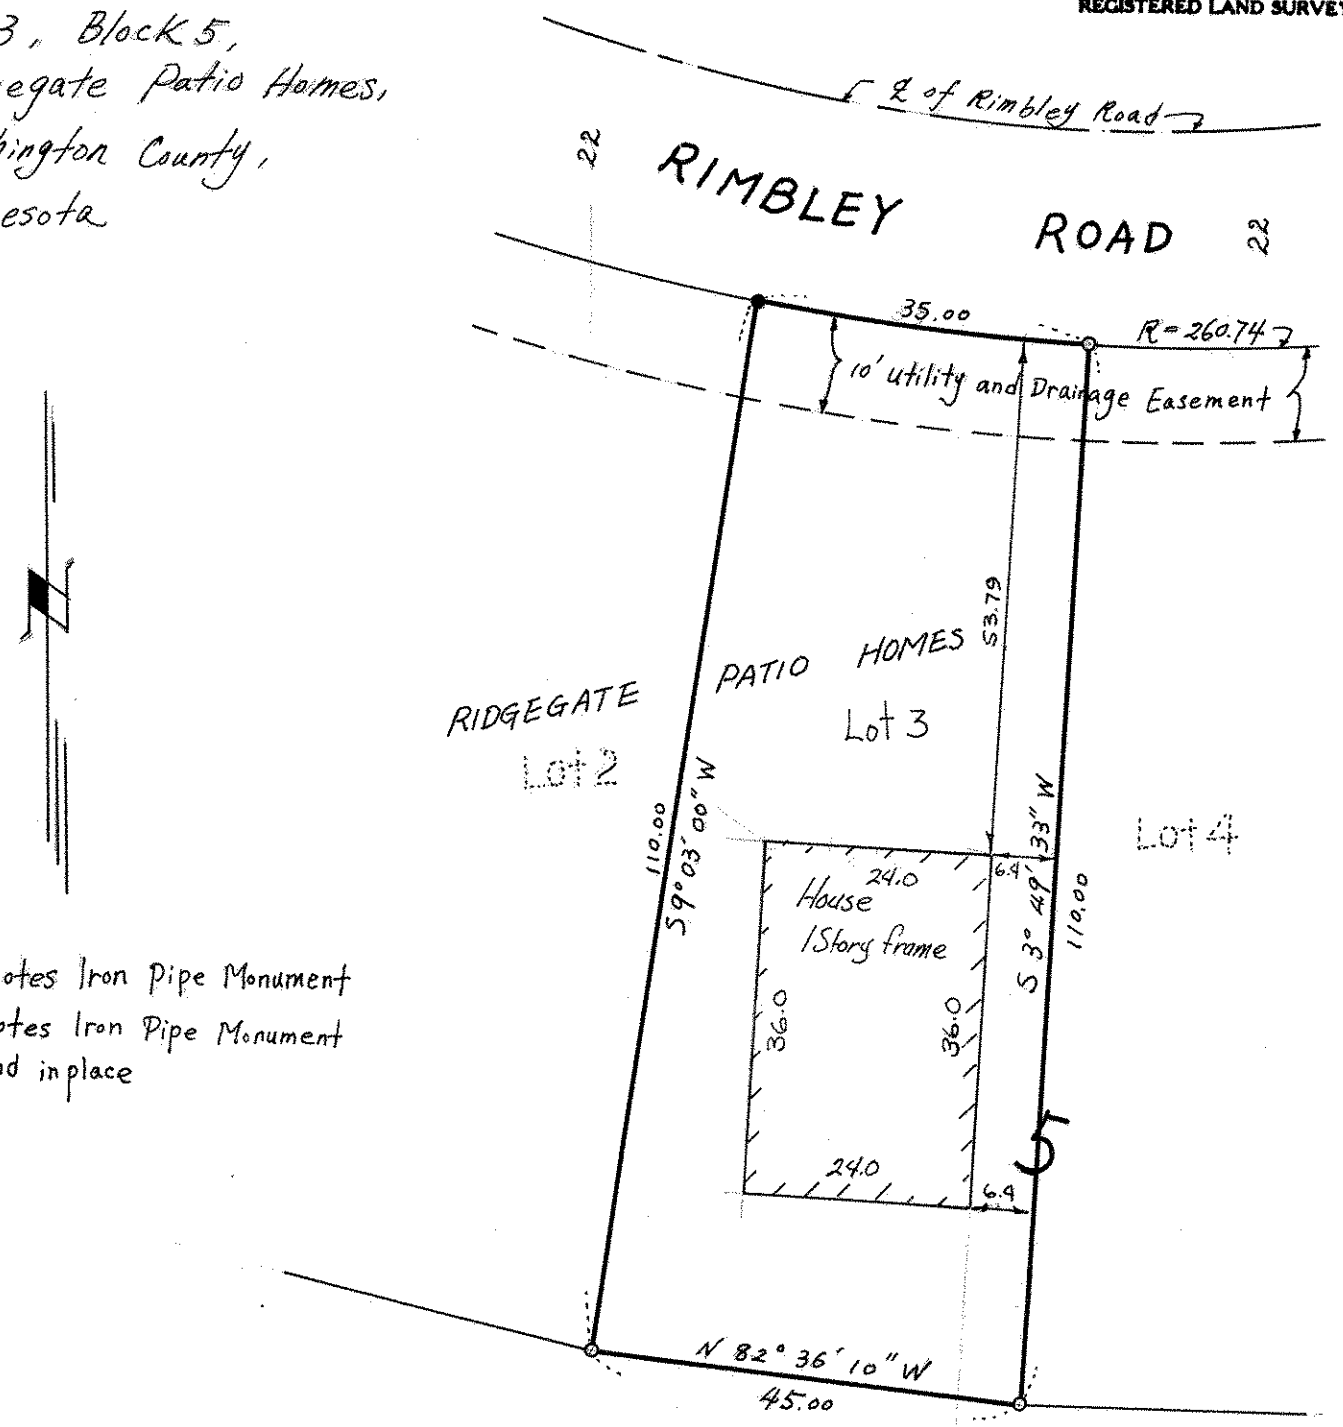

○ Denotes Iron Pipe Monument
● Denotes Iron Pipe Monument found in place