

FROM THE OFFICE OF

CHARLES O. GEORGI COMPANY

2215 West County Road B

Saint Paul, Minnesota 55113

REGISTERED CIVIL ENGINEER AND LAND SURVEYOR

**Certificate
of Survey**

I Heroby Certify that this plat shows a survey made by me of the property described on this plat, and that the corners are correctly placed as shown, and that all locations have been correctly shown. 1/10/78 Added House Location 20' N

Surveyed For Ted Glasrud Assoc.

Date October 1977

Scale 1" = 20'

By Charles O. Georgi
REGISTERED LAND SURVEYOR


Description:

Lot 2,
Block 7,
Ridgegate,
Washington County,
Minnesota

40

CANBERRA LANE

8
H

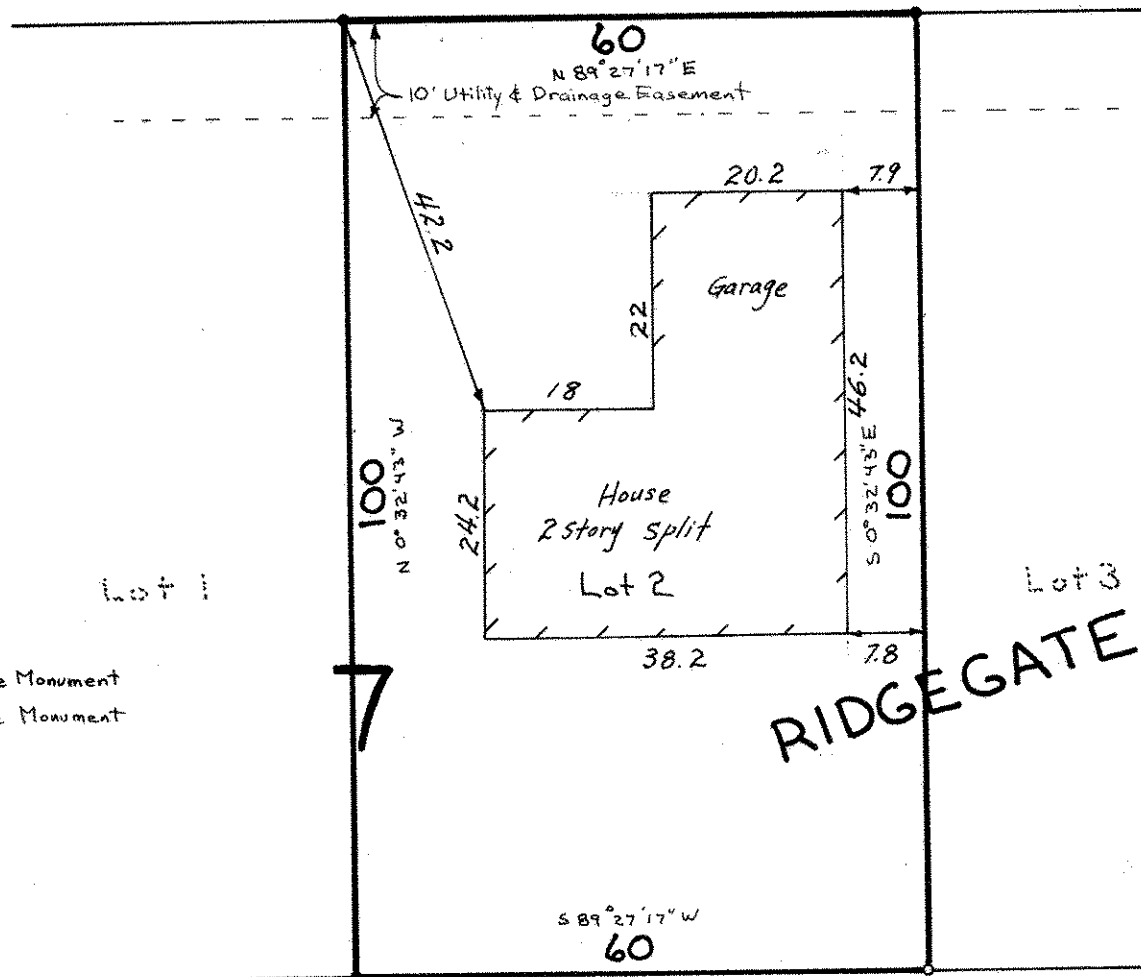

- Denotes Iron Pipe Monument
- Denotes Iron Pipe Monument found in place