

NE 17 28 21

FROM THE OFFICE OF

CHARLES O. GEORGI COMPANY

2215 West County Road B

Saint Paul, Minnesota 55113

REGISTERED CIVIL ENGINEER AND LAND SURVEYOR

Certificate of Survey

I Hereby Certify that this plat shows a survey made by me of the property described on this plat, and that the corners are correctly placed as shown, and that all locations have been correctly shown. 4/17/78 Added House location C.O.G.

Surveyed For Ted Glasrud

Date Jan. 1978

Scale 1" = 30'

By Charles O. Georgi
REGISTERED LAND SURVEYOR


Description:

Lot 11, Block 20.

Ridgegate.

Washington County.

Minnesota

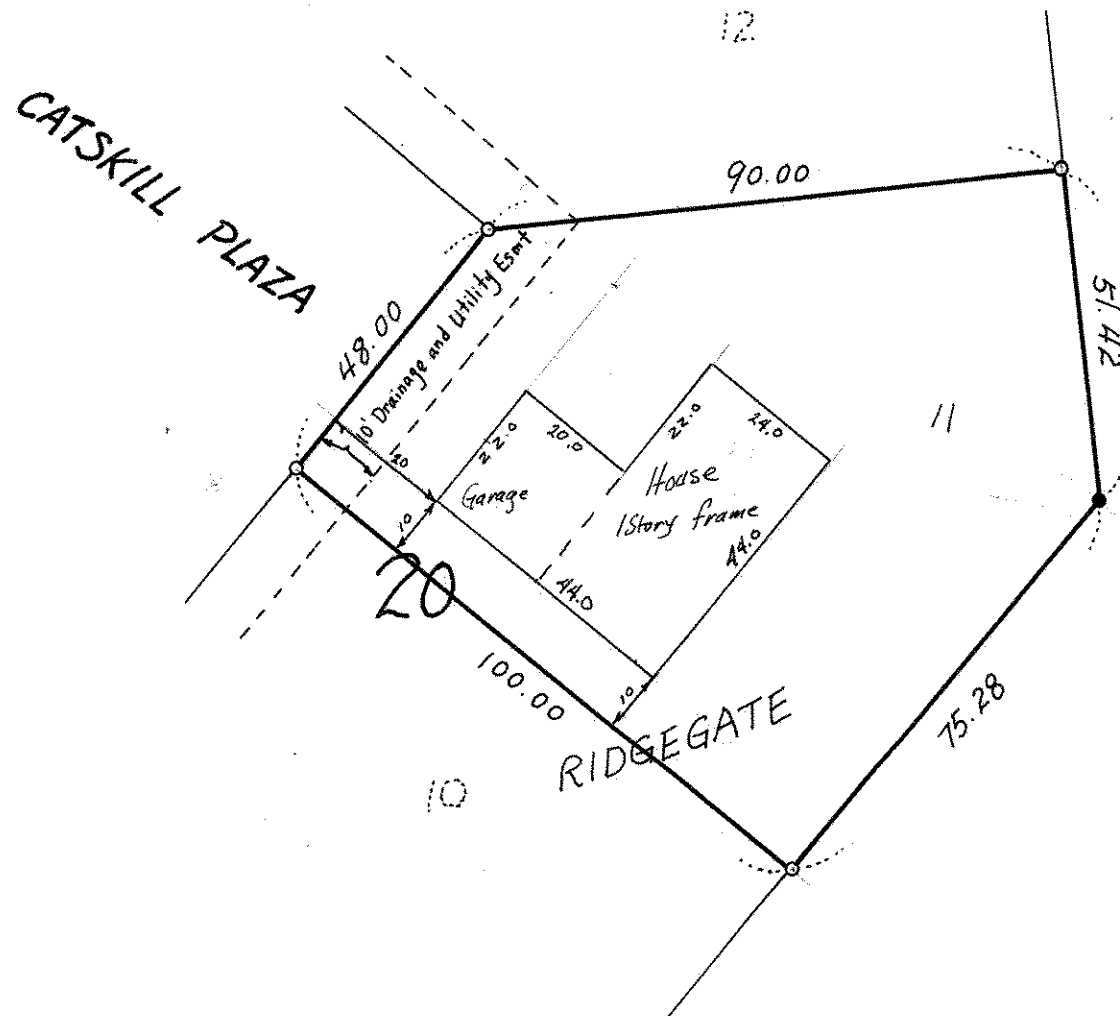

- Denotes Iron Monument
- Denotes Iron Monument found in place