NE 17 28 21

# Certificate of Survey

From the office of

**GEORGI- SCHMIDT & ASSOC. INC.**

3092 No. Lexington Ave., Roseville, Mn. 55113
LAND SURVEYING
483-4408

**I Hereby Certify that** this plat shows a survey made by me of the property described on this plat, and that the corners are correctly placed as shown, and that all locations have been correctly shown.

Job Number: 259

Surveyed For Ted Glasrud Assoc.

Date Feb 21, 1979

Scale 1 in. = 20 ft.

By Gerald W Schmidt
REGISTERED LAND SURVEYOR

Description: Lot 3 Block 3
RIDGEGATE

Washington County, MN.

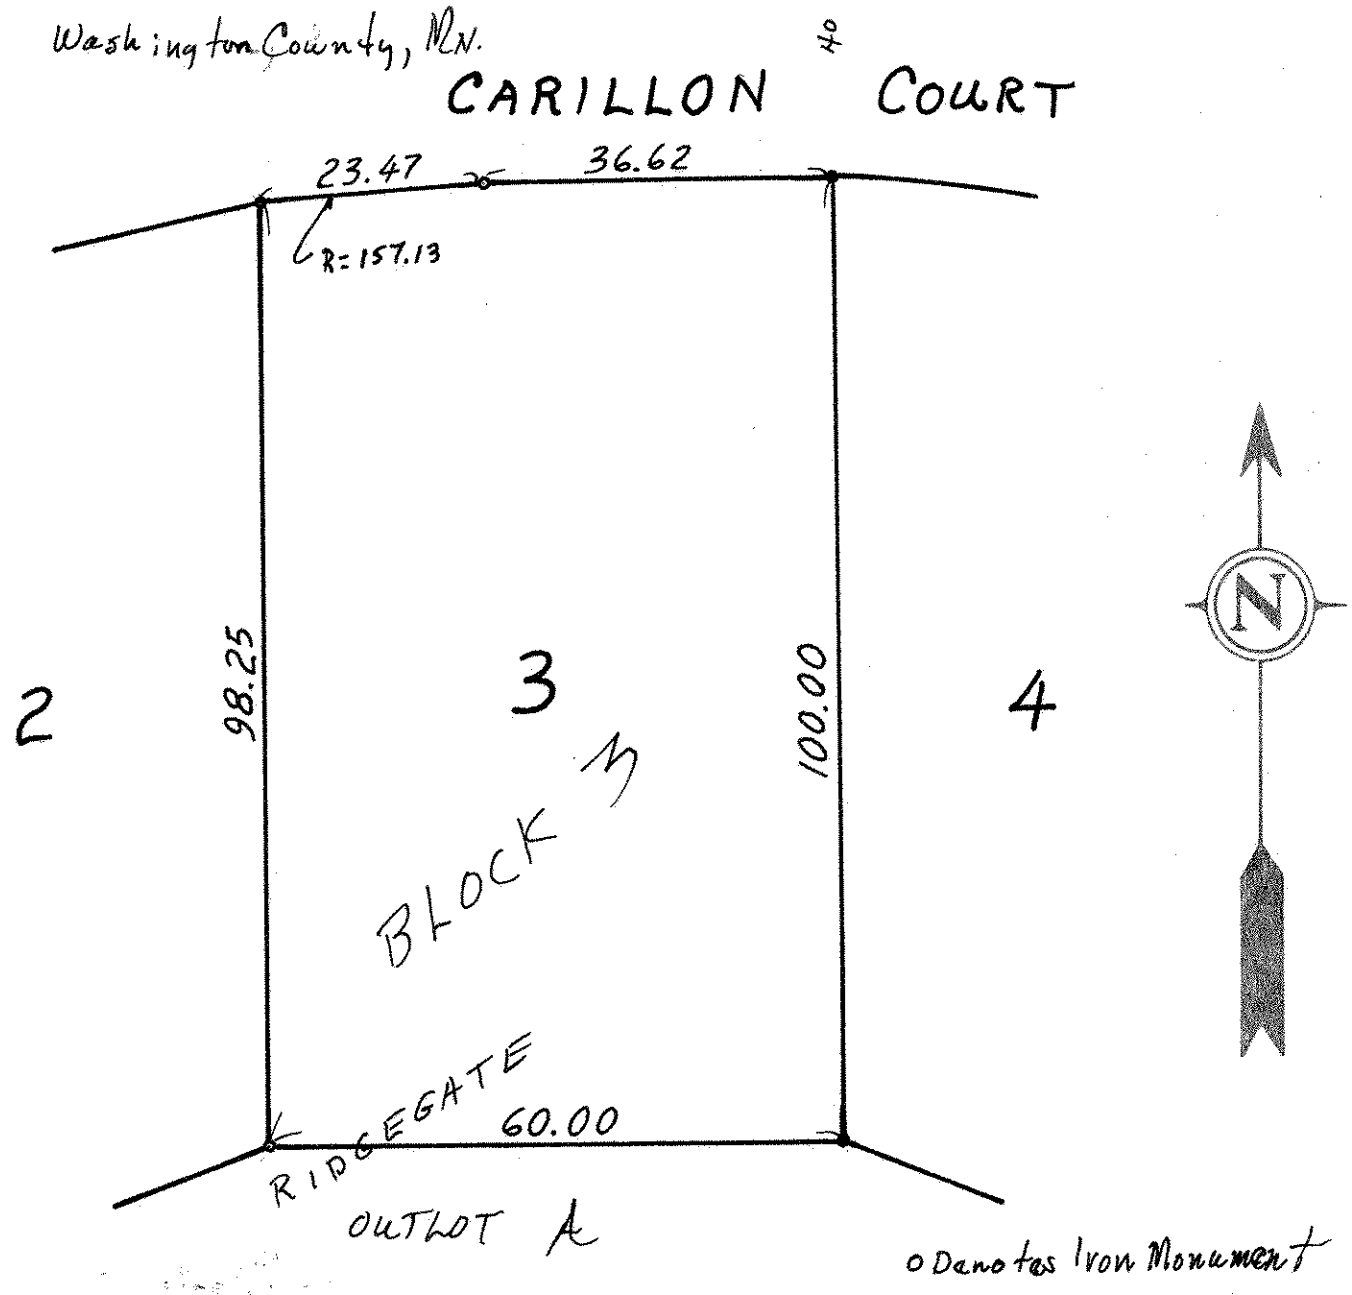


o Dano tes Iron Monument