

# Certificate of Survey

From the office of  
**GEORGI-SCHMIDT & ASSOC. INC.**

3092 No. Lexington Ave., Roseville, Mn. 55113

LAND SURVEYING

483-4408

I Hereby Certify that this plat shows a survey made by me of the property described on this plat, and that the corners are correctly placed as shown, and that all locations have been correctly shown.

Job Number: 236

Surveyed For Ted Glasrud Assoc

Date January 1979

Scale 1"=20'


6/27/79 Added House Location DWS

By Donald W Schmidt  
REGISTERED LAND SURVEYOR

Description:

Lot 6,  
Block 14,  
Ridgegate  
Washington County,  
Minnesota.

CHYENNE PLAZA  
WEST

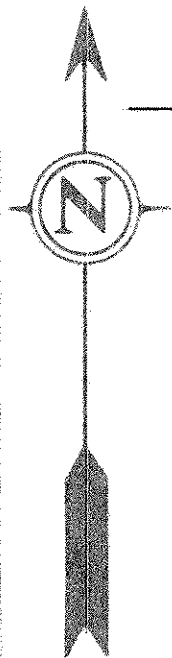

o Denotes iron pipe monument.  
● Denotes iron found

