

NE 1728 21

Certificate of Survey

From the office of GEORGI-SCHMIDT & ASSOC. INC. 3092 No. Lexington Ave., Roseville, Mn. 55113 LAND SURVEYING 483-4408

I Hereby Certify that this plat shows a survey made by me of the property described on this plat, and that the corners are correctly placed as shown, and that all locations have been correctly shown.

Job Number: 135

Surveyed For: The Glasvad Assoc.


Date: October 3, 1978

Scale: 1"=20'

By: Donald W. Schmidt REGISTERED LAND SURVEYOR

Description:

Lots 1 thru 4, Block 9, Ridgagate Third Addition Washington County, Minnesota N 89° 53' 40" E North line Ridgagate Third Addition

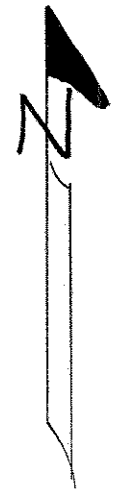

BLOCK 8 Lot 1

● Denotes iron in place 9/29/78

Access by private drive

* Lot Line denotes where centerline of foundation wall is on lot line, and above foundation there are two 4" walls separated by an air space that is on lot line.

