8 27 21

FROM THE OFFICE OF

CHARLES O. GEORGI COMPANY

2215 West County Road B — Saint Paul 13, Minnesota

REGISTERED CIVIL ENGINEER AND LAND SURVEYOR

Certificate of Survey

I Hereby Certify that this plat shows a survey made by me of the property described on this plat, and that the corners are correctly placed as shown, and that all locations have been correctly shown.

Surveyed For P. Olson

Date December 1958

Scale 1" = 100'

By Charles O. Georgi
REGISTERED LAND SURVEYOR

Description: Subject to De Montreville Road, all that part of Government Lot 1, Section 8, T29N, R21W, Washington County, Minn described as follows: Beginning at a point on the North line of said Government Lot 1, distant 966.7 feet West of the Northeast of said Government Lot 1, thence Southeasterly by a deflection angle of 108°00' to the left from the easterly direction of said North line a distance of 261.0 feet to a point, thence Southwesterly by a deflection angle of 69°32' to the right a distance of 55.3 feet along the shore line of Olson Lake, thence Southwesterly by a deflection angle of 34°04' to the left a distance of 4.7 feet along the shore line of Olson Lake, thence Northwesterly by a deflection angle of 120°16' to the right a distance of 388.0 feet to a point on the North line of said Government Lot 1, thence Easterly 225.0 feet to the point of beginning.

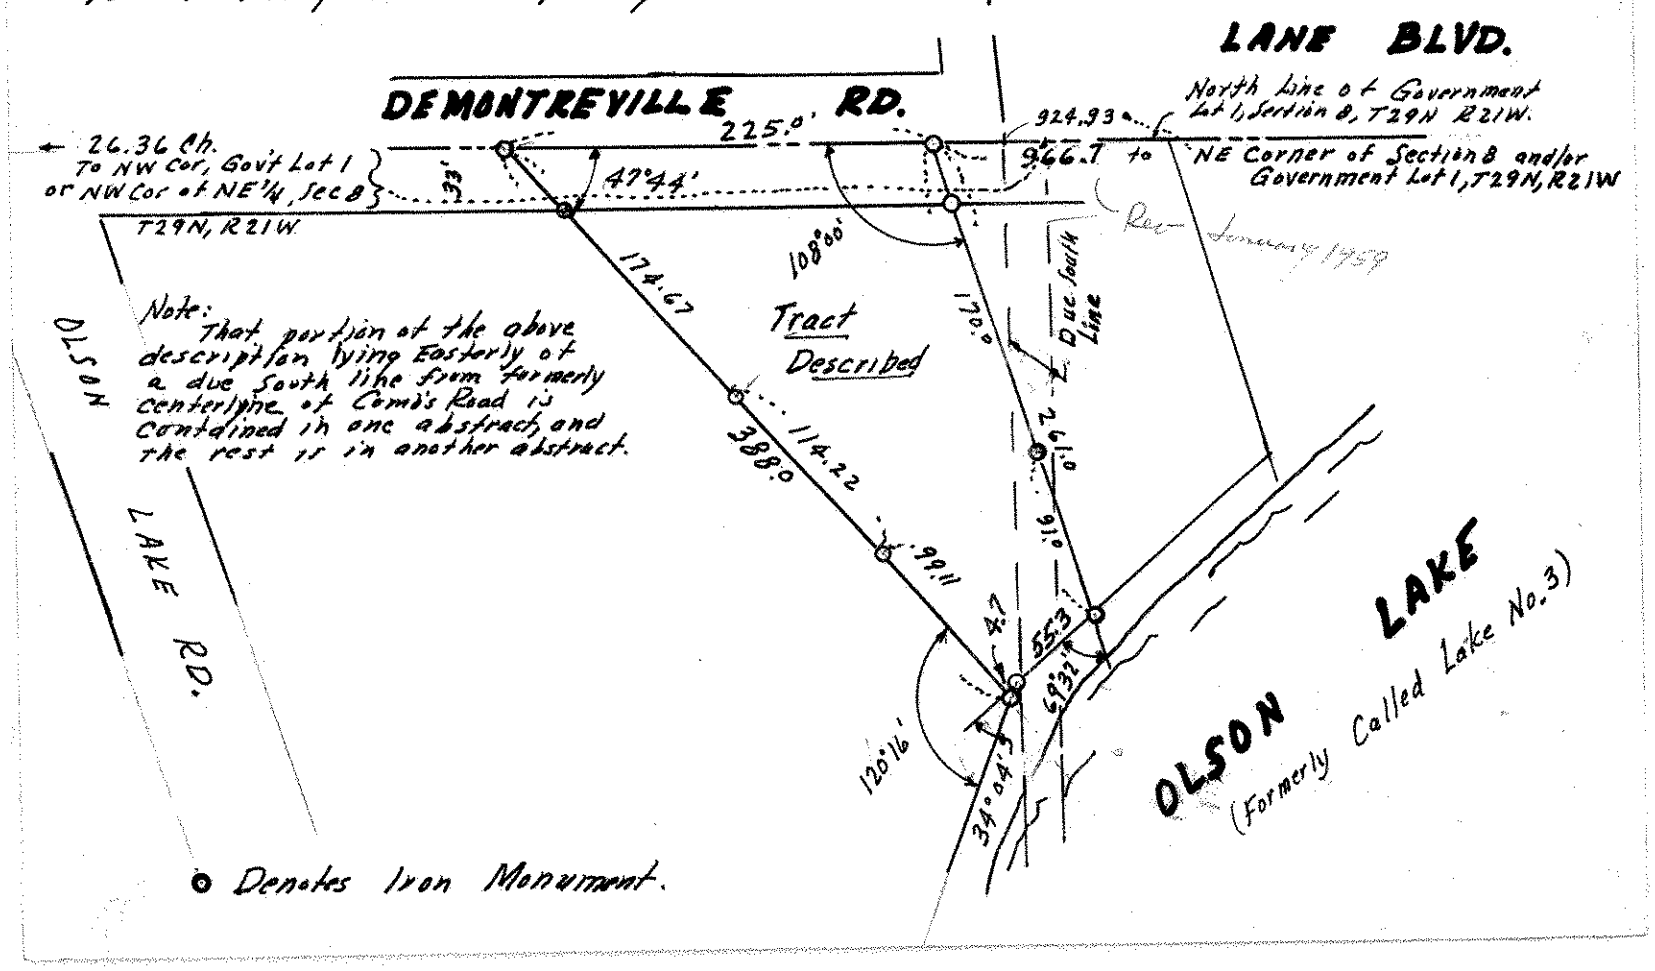

Note: That portion of the above description lying Easterly of a due South line from formerly centerline of Combs Road is contained in one abstract, and the rest is in another abstract.

● Denotes Iron Monument.