JW 7 2921

FROM THE OFFICE OF

CHARLES O. GEORGI COMPANY

2215 West County Road B Saint Paul 13, Minnesota

REGISTERED CIVIL ENGINEER AND LAND SURVEYOR

Certificate of Survey

I Hereby Certify that this plat shows a survey made by me of the property described on this plat, and that the corners are correctly placed as shown, and that all locations have been correctly shown. All existing low wet areas are not shown.

Surveyed For C.W. Springborn

Date May 1961

Scale 1" = 200'

By Charles O. Georgi
REGISTERED LAND SURVEYOR
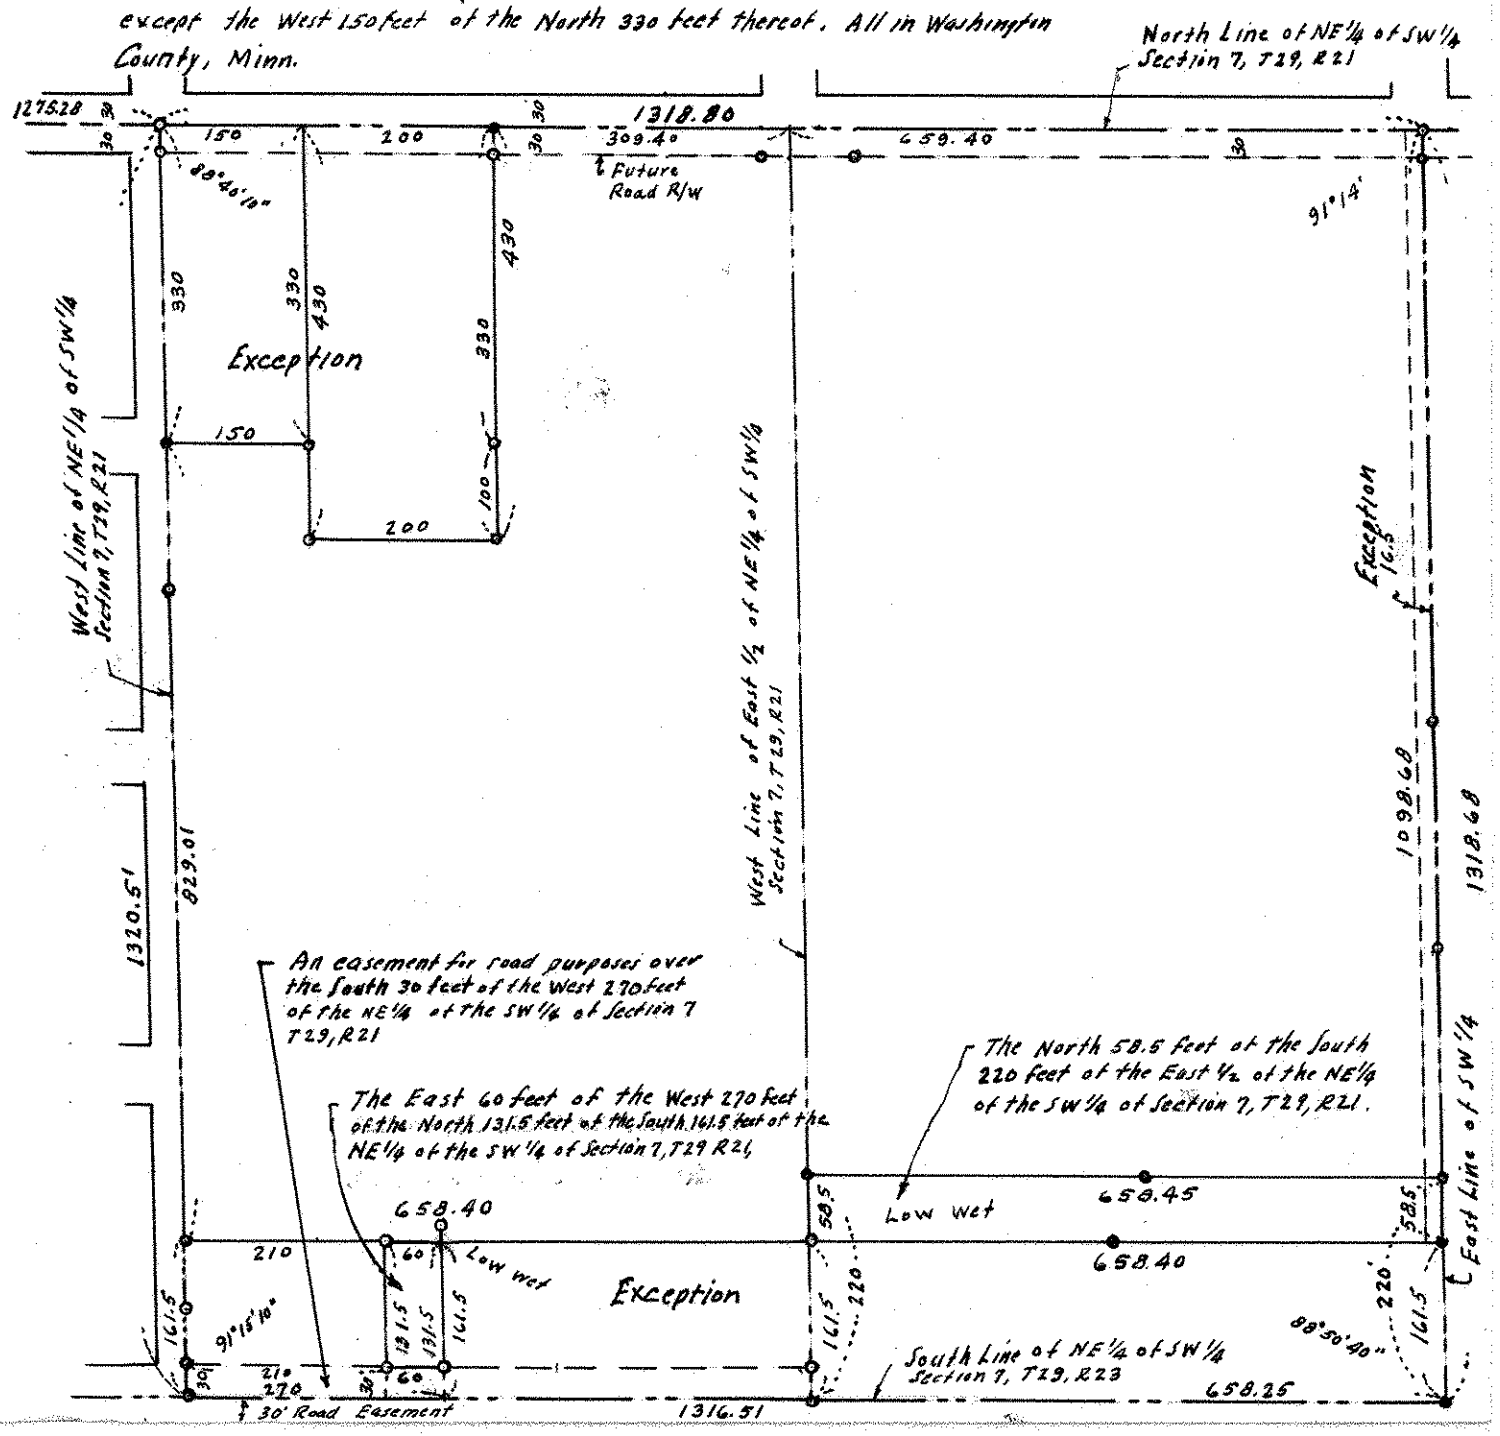
Present Description: The NE 1/4 of the SW 1/4 of Section 7, T29, R21 except the South 161.5 feet thereof and the East 16.5 feet thereof; and except the East 200 feet of the West 350 feet of the North 430 feet; and except the West 150 feet of the North 330 feet thereof. All in Washington County, Minn.