

FROM THE OFFICE OF

CHARLES O. GEORGI COMPANY

2215 West County Road B

Saint Paul 13, Minnesota

REGISTERED CIVIL ENGINEER AND LAND SURVEYOR

Certificate
of Survey

I Hereby Certify that this plat shows a survey made by me of the property described on this plat, and that the corners are correctly placed as shown, and that all locations have been correctly shown. All existing low wet area are not shown.


Surveyed For G. KUENG.....

Date May 1961.....

Scale 1" = 200'

Present Description: The NE 1/4 of the SE 1/4 of the SW 1/4 of Section 7, T29, R21 together with an easement along and across the North 30 feet of the NW 1/4 of the SE 1/4 of the SW 1/4 of Section 7, T29, R21; Also the South 161.5 feet of the NE 1/4 of the SW 1/4 of Section 7, T29, R21.

By Charles O. Georgi
REGISTERED LAND SURVEYOR

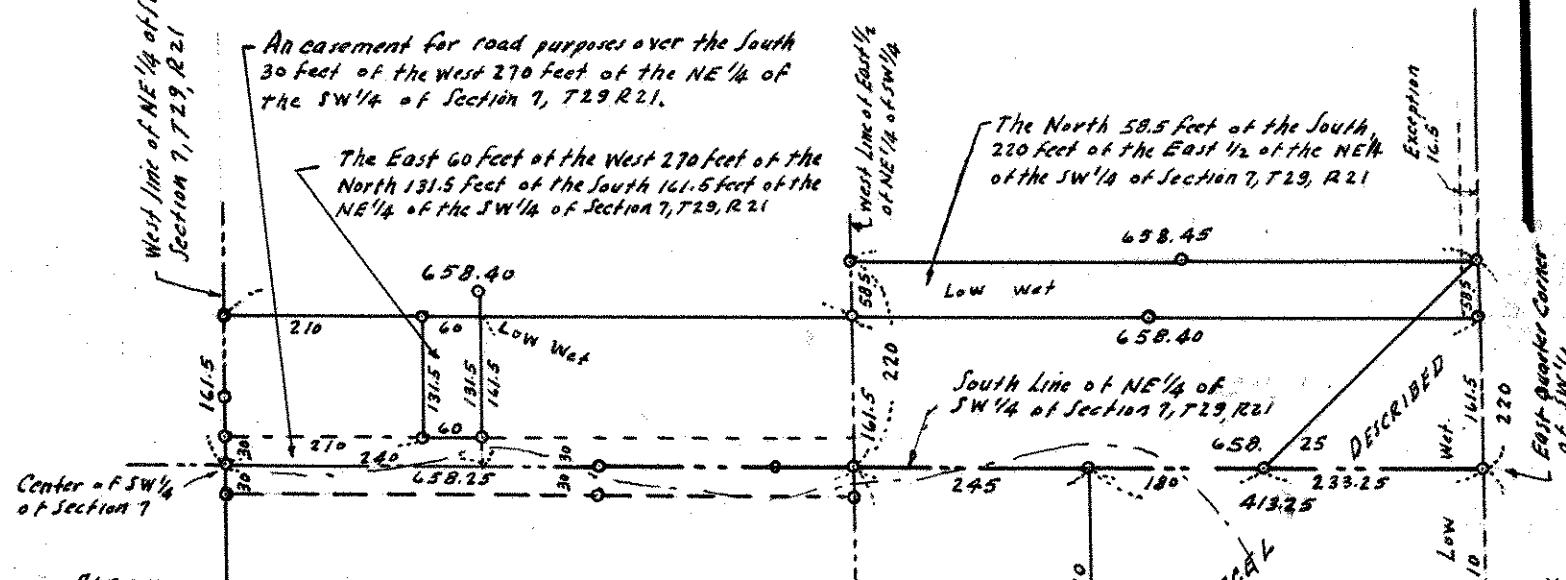

PARCEL:

The North 210 feet of the NE 1/4 of the SE 1/4 of the SW 1/4 of Section 7, T29, R21 except the West 245 feet thereof. Also a triangular portion of the South 220 feet of the East 1/4 of the NE 1/4 of the SW 1/4 of said Section 7 lying southeasterly of the following described line: beginning at a point on the East line of SW 1/4 of said Section 7 distant 220 feet North of the East Quarter corner of the SW 1/4 of said Section 7, thence southwesterly to a point on the South line of the NE 1/4 of the SW 1/4 of said Section 7 distant 233.25 feet west of the East Quarter corner of the SW 1/4 of said Section 7; and there terminating.

Also an easement for road purposes over the existing driveway and subject to existing driveway over and across the above described parcel.

Note:

Driveway easements to be defined more precisely per owners agreement.

The 16.5' exception to be clarified by present owner

○ Denotes Iron Monument.