

FROM THE OFFICE OF

# CHARLES O. GEORGI COMPANY

2215 West County Road B

Saint Paul, Minnesota 55113

REGISTERED CIVIL ENGINEER AND LAND SURVEYOR

## Certificate of Survey

I Hereby Certify that this plat shows a lot survey made by me on the property described on this plat, and that all locations, have been correctly shown, and corners are correctly placed or shown


For Charles G. Brockman Estates  
Date May, 1971

Scale 1" = 40'

By *Charles O. Georgi*  
REGISTERED LAND SURVEYOR

### Description:

Lots 7 and 8, Block 2  
Midvale Division No. 2  
Washington County, Minn

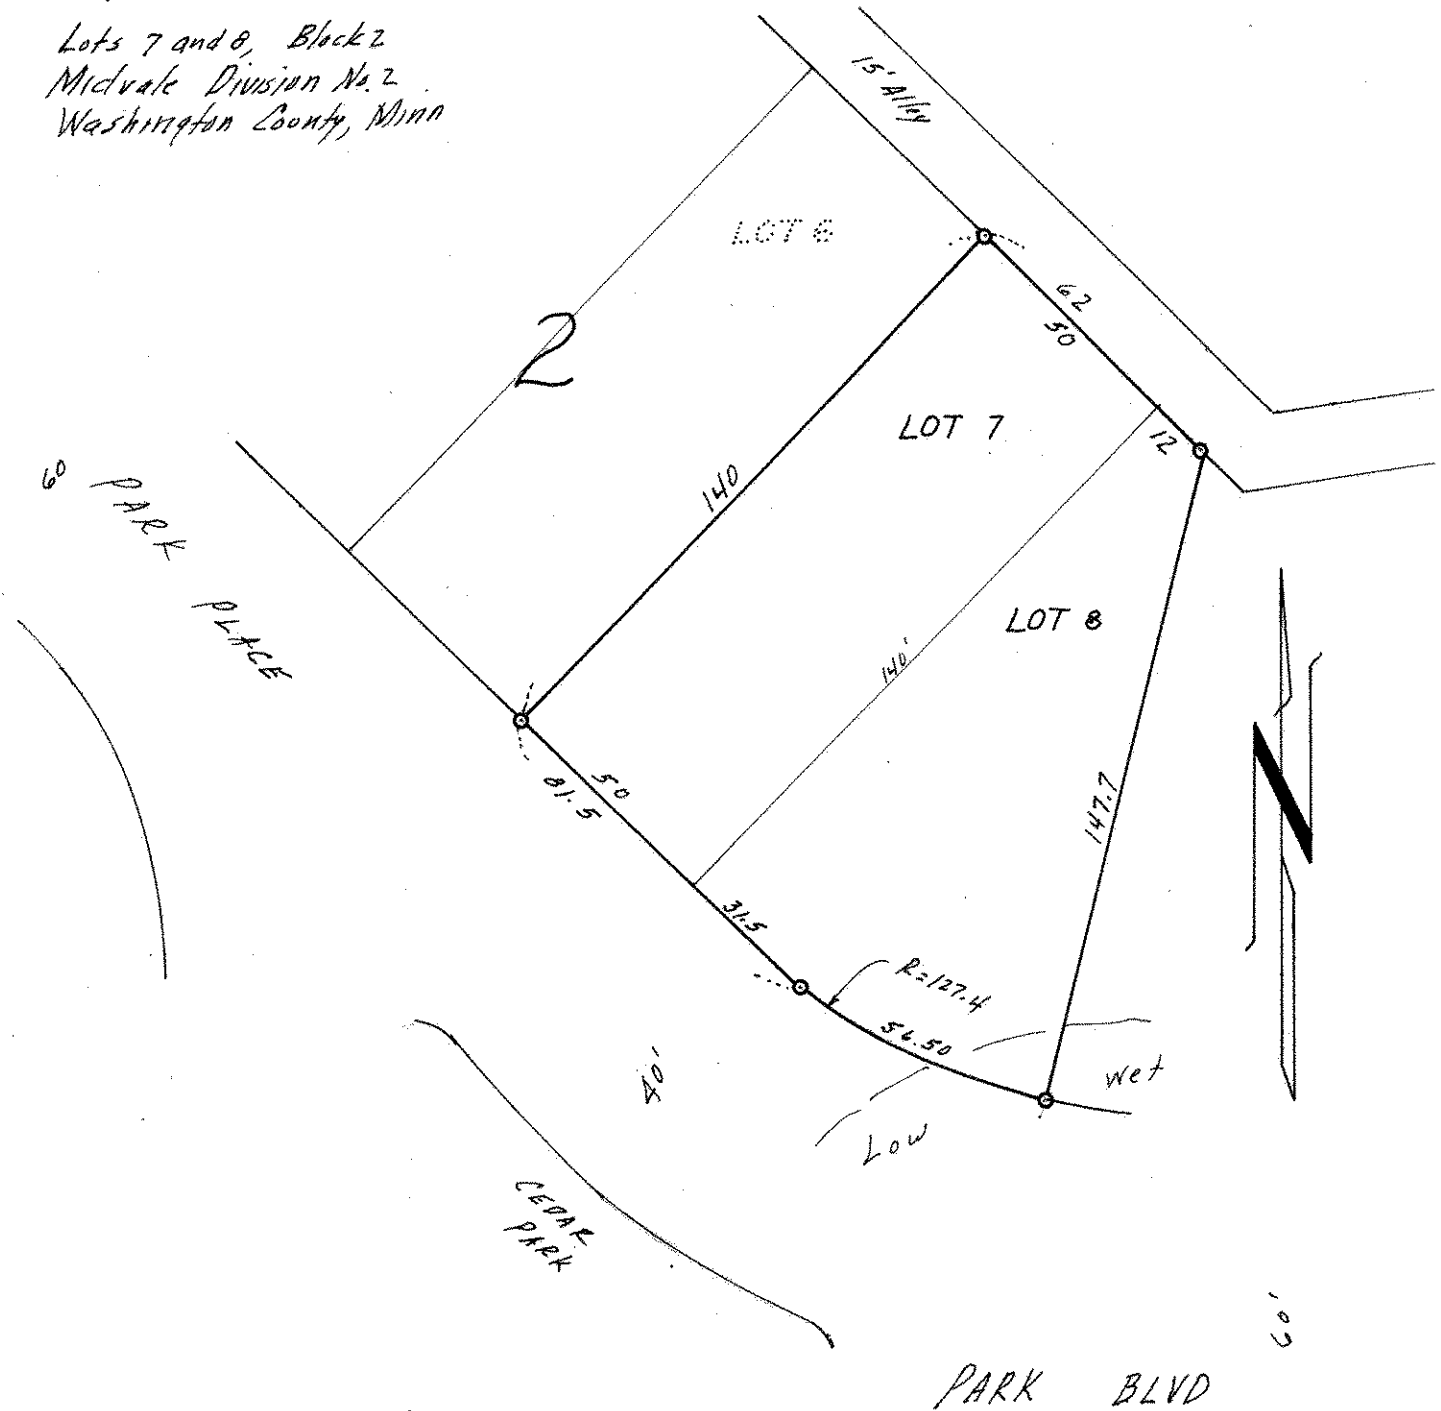

○ Denotes Iron Pipe Monument