

FROM THE OFFICE OF

CHARLES O. GEORGI COMPANY

2215 West County Road B

Saint Paul, Minnesota 55113

REGISTERED CIVIL ENGINEER AND LAND SURVEYOR

Certificate of Survey

I Hereby Certify that this plat shows a survey made by me of the property described on this plat, and that the corners are correctly placed as shown, and that all locations have been correctly shown.

Surveyed For Rocky Rockholt


Date Sept 1975

Scale 1" = 40'

By Charles O. Georgi
REGISTERED LAND SURVEYOR

Description:

All of Lot 19 and that part of lot 18, lying Westerly of the following described line: beginning at a point on the SWdy; line of said lot 18, distant 42.0 feet SEdy of the most Westerly Corner of said lot 18; thence Northerly to a point on the NEdy line of lot 18 distant 9.0 feet SEdy of the most Northerly corner of said lot 18 and there terminating; Block 3, Midvale Division No. 2, Washington County, Minnesota.

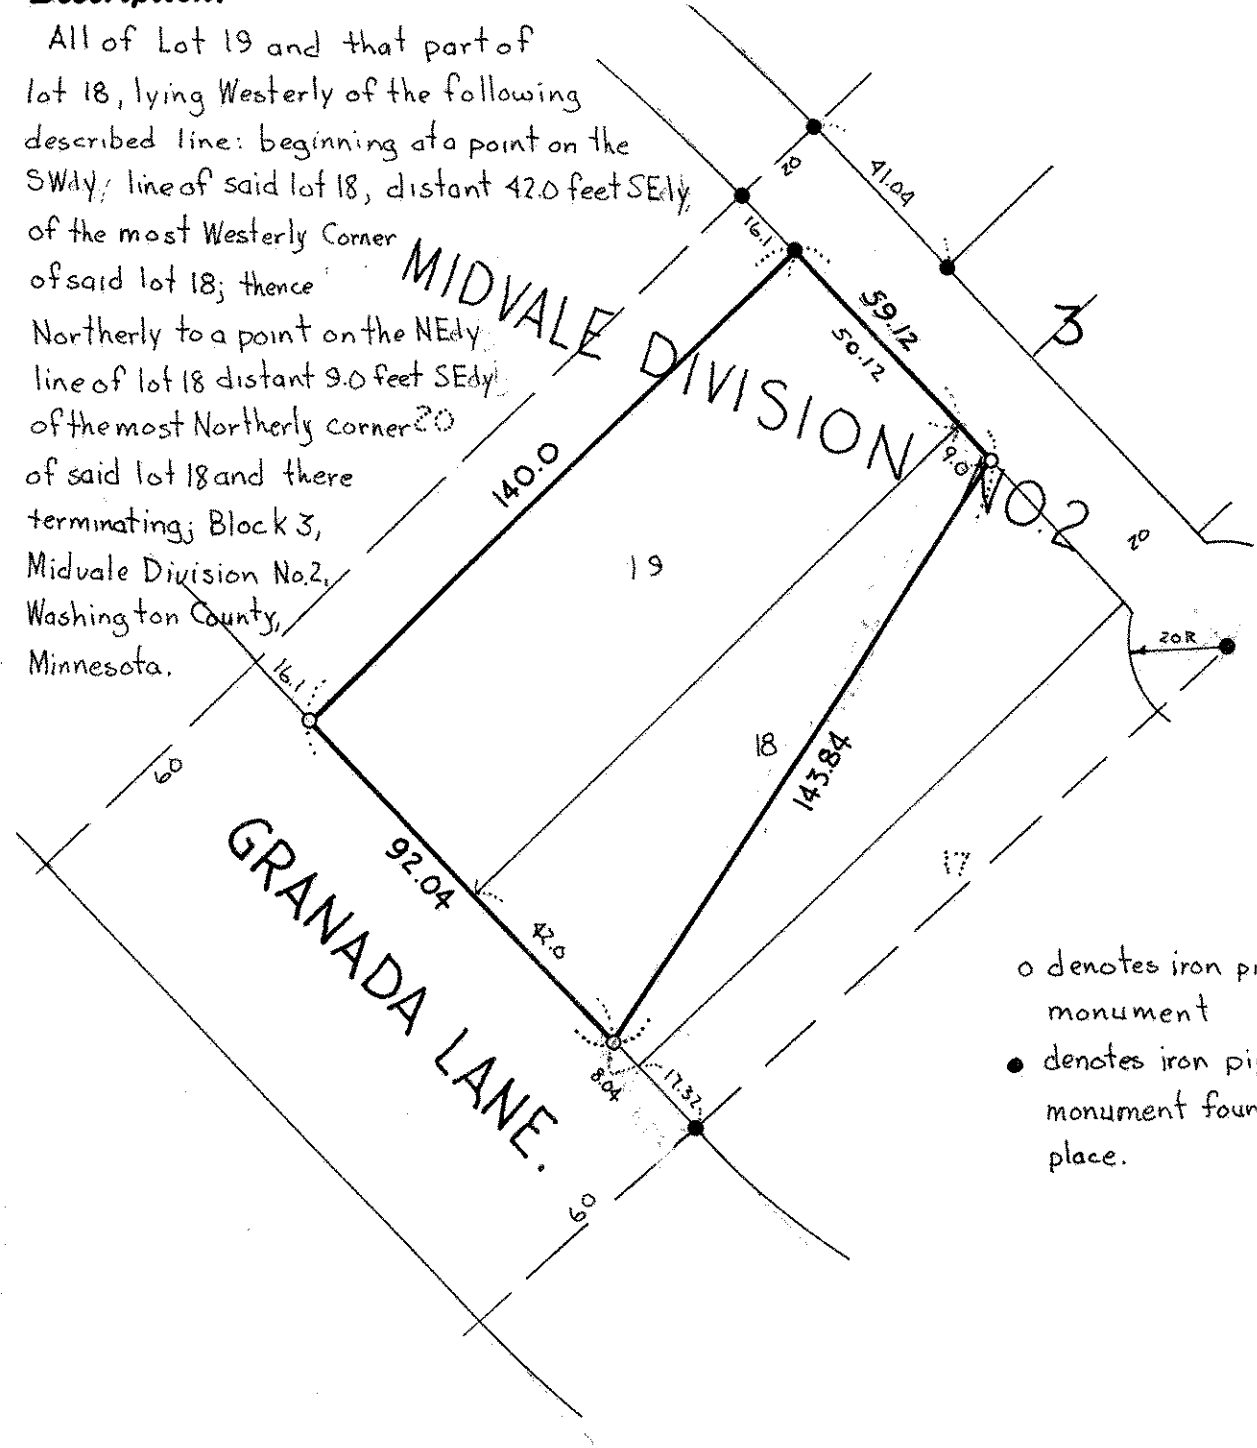

- o denotes iron pipe monument
- denotes iron pipe monument found in place.