


SURVEY OF E-100' OF LOT 17, BLK-2
TOWN OF WILSON- LINCOLN TWP

20-30-21

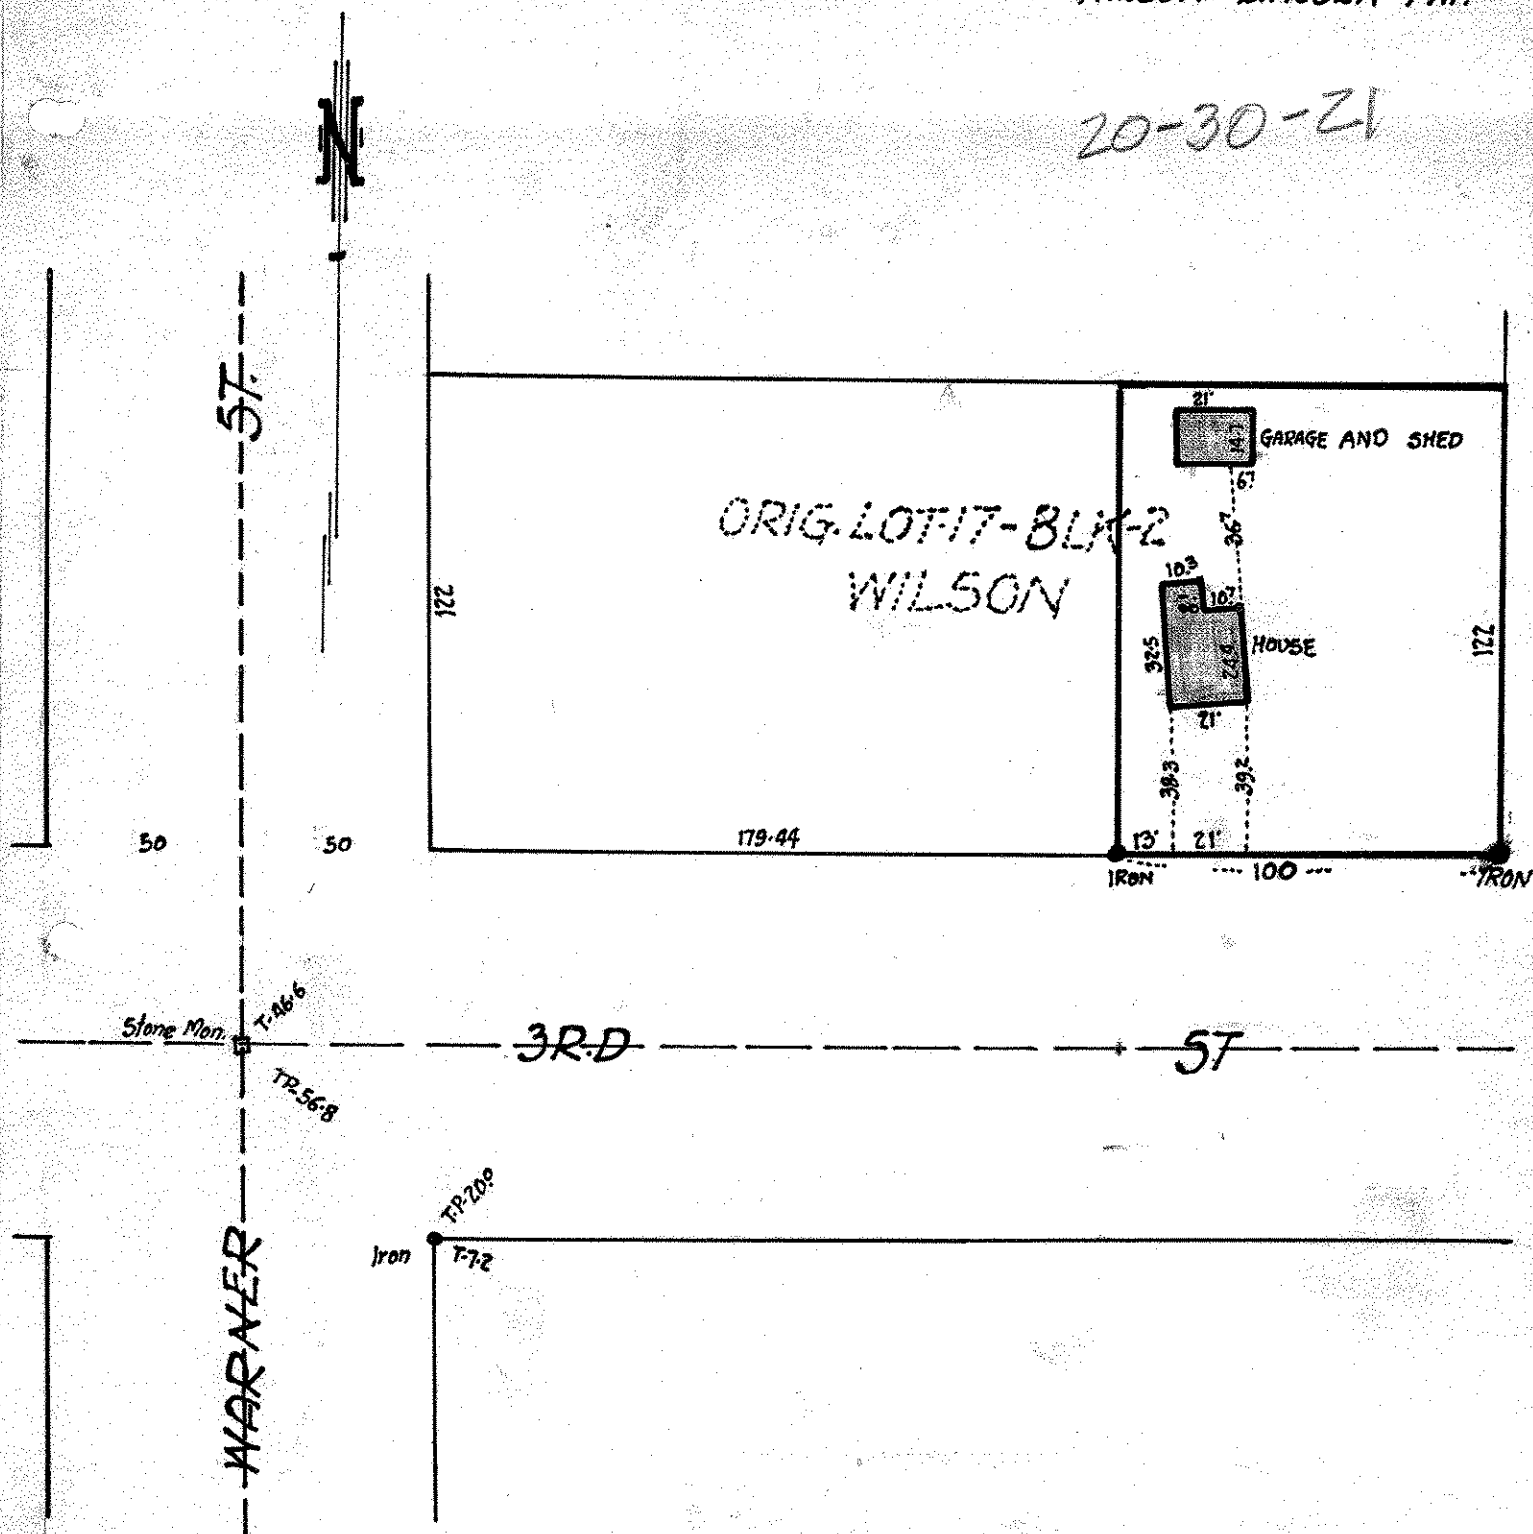

That part of the SW 1/4 of NE 1/4, Sec. 20, T. 30-N R. 21-W
formerly platted as the E-100' of Lot-17-Block-2, Town of
Wilson, now vacated

P.R. Benicio
Registered Professional Engr.
Office - 69-7th Ave - North St. Paul
Phone - N. St. P. 407

Scale - 50' = 1"

Nov. 24-1928