


SURVEY OF LOT 7, BLK-11
TOWN OF WILSON (YAC.)

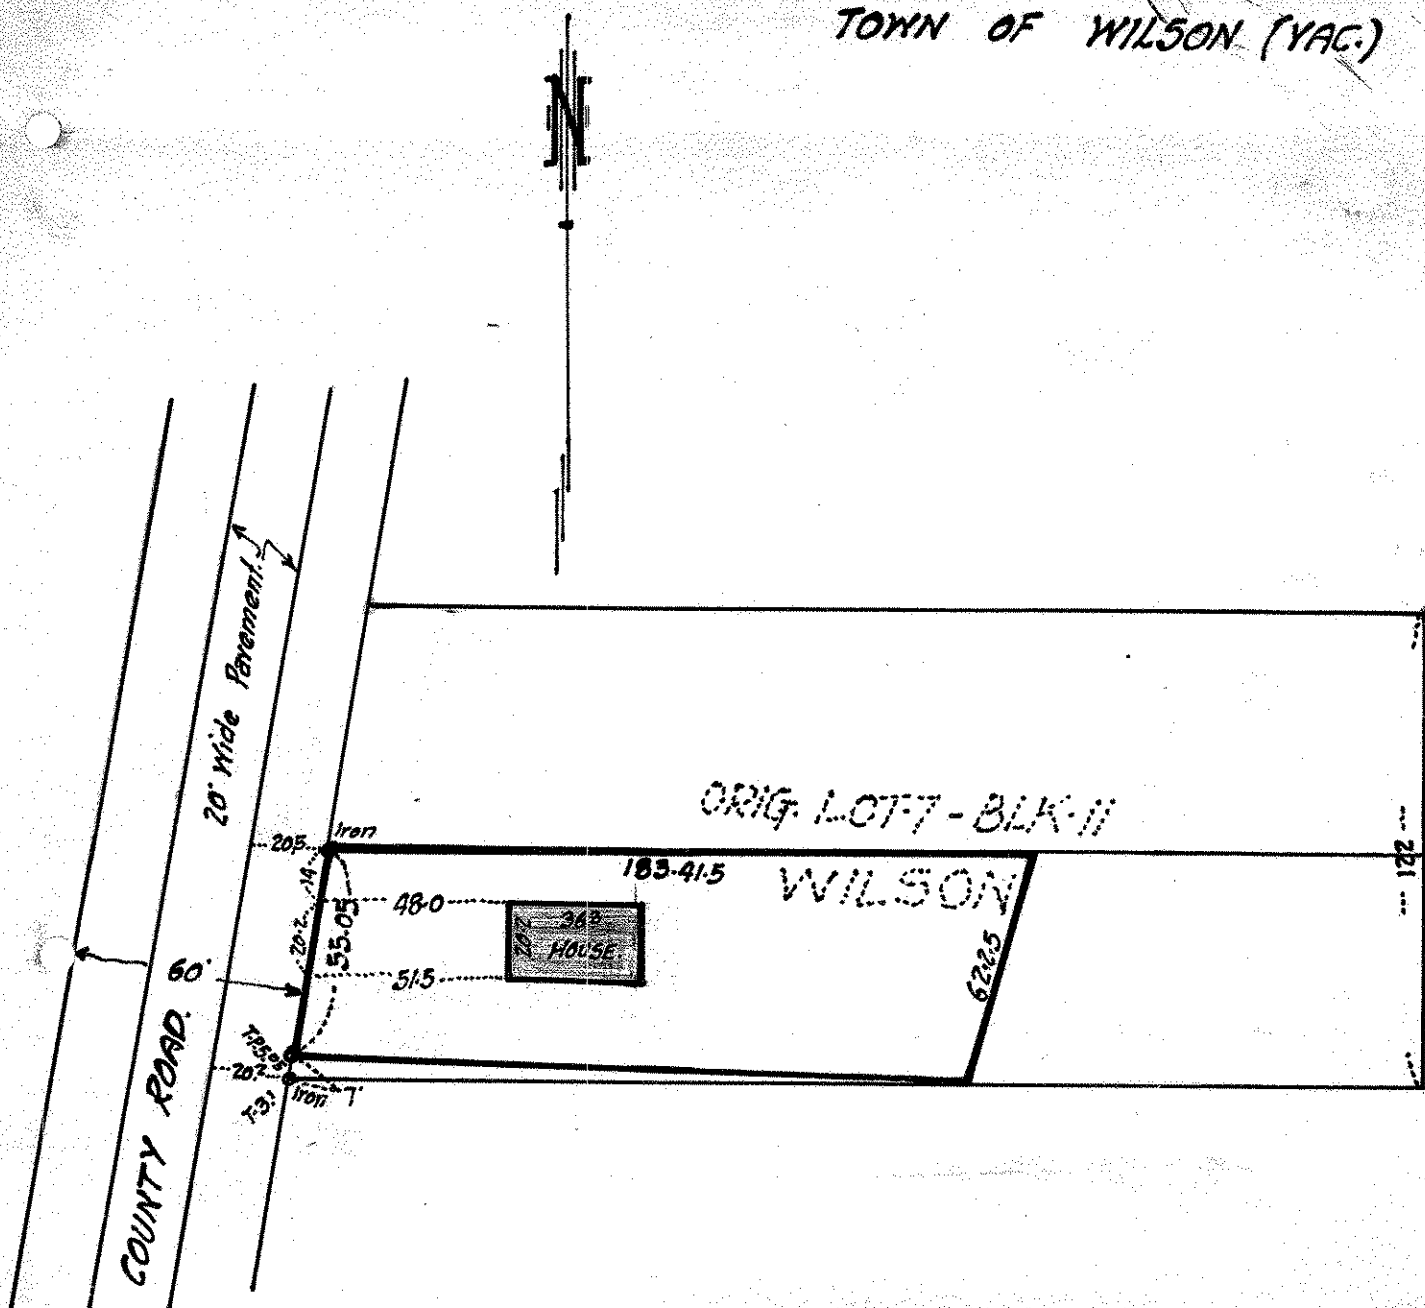

Commence at a point on the E. line of County Road - 7 ft. northerly of the point where the south line of former Lot 7 - Blk-11, Town of Wilson according to plat on record there of: produced westerly - intersects said county road thence northerly along the easterly line of said county road - 55.05 ft. thence easterly on a line parallel with northerly line of said Lot 7, Blk-11 as afore-said - 183.415 ft. to a point, thence southeasterly on a line parallel with the westerly line of the right of way of the St. Paul and White Bear Ry. 62.25 ft. to the south line of said Lot 7, Blk-11 afore said, thence in a direct line westerly to the point of beginning

R.R. Benister
Registered Professional Engr.
Office - 69-7th Ave - North St. Paul
Phone - N. St. P. 407.

Scale - 50' = 1" Nov-24-1928