


Certificate  
of Survey

From the office of  
**GEORGI-SCHMIDT & ASSOC. INC.**  
3092 No. Lexington Ave., Roseville, Mn. 55113  
LAND SURVEYING  
483-4408

I Hereby Certify that this plat shows a survey made by me of the property described on this plat, and that the corners are correctly placed as shown, and that all locations have been correctly shown.

Job Number: 1051  
Surveyed For: Victory Devel. Co.  
Date: Aug 1981  
Scale: 1" = 40'

By: [Signature]  
REGISTERED LAND SURVEYOR

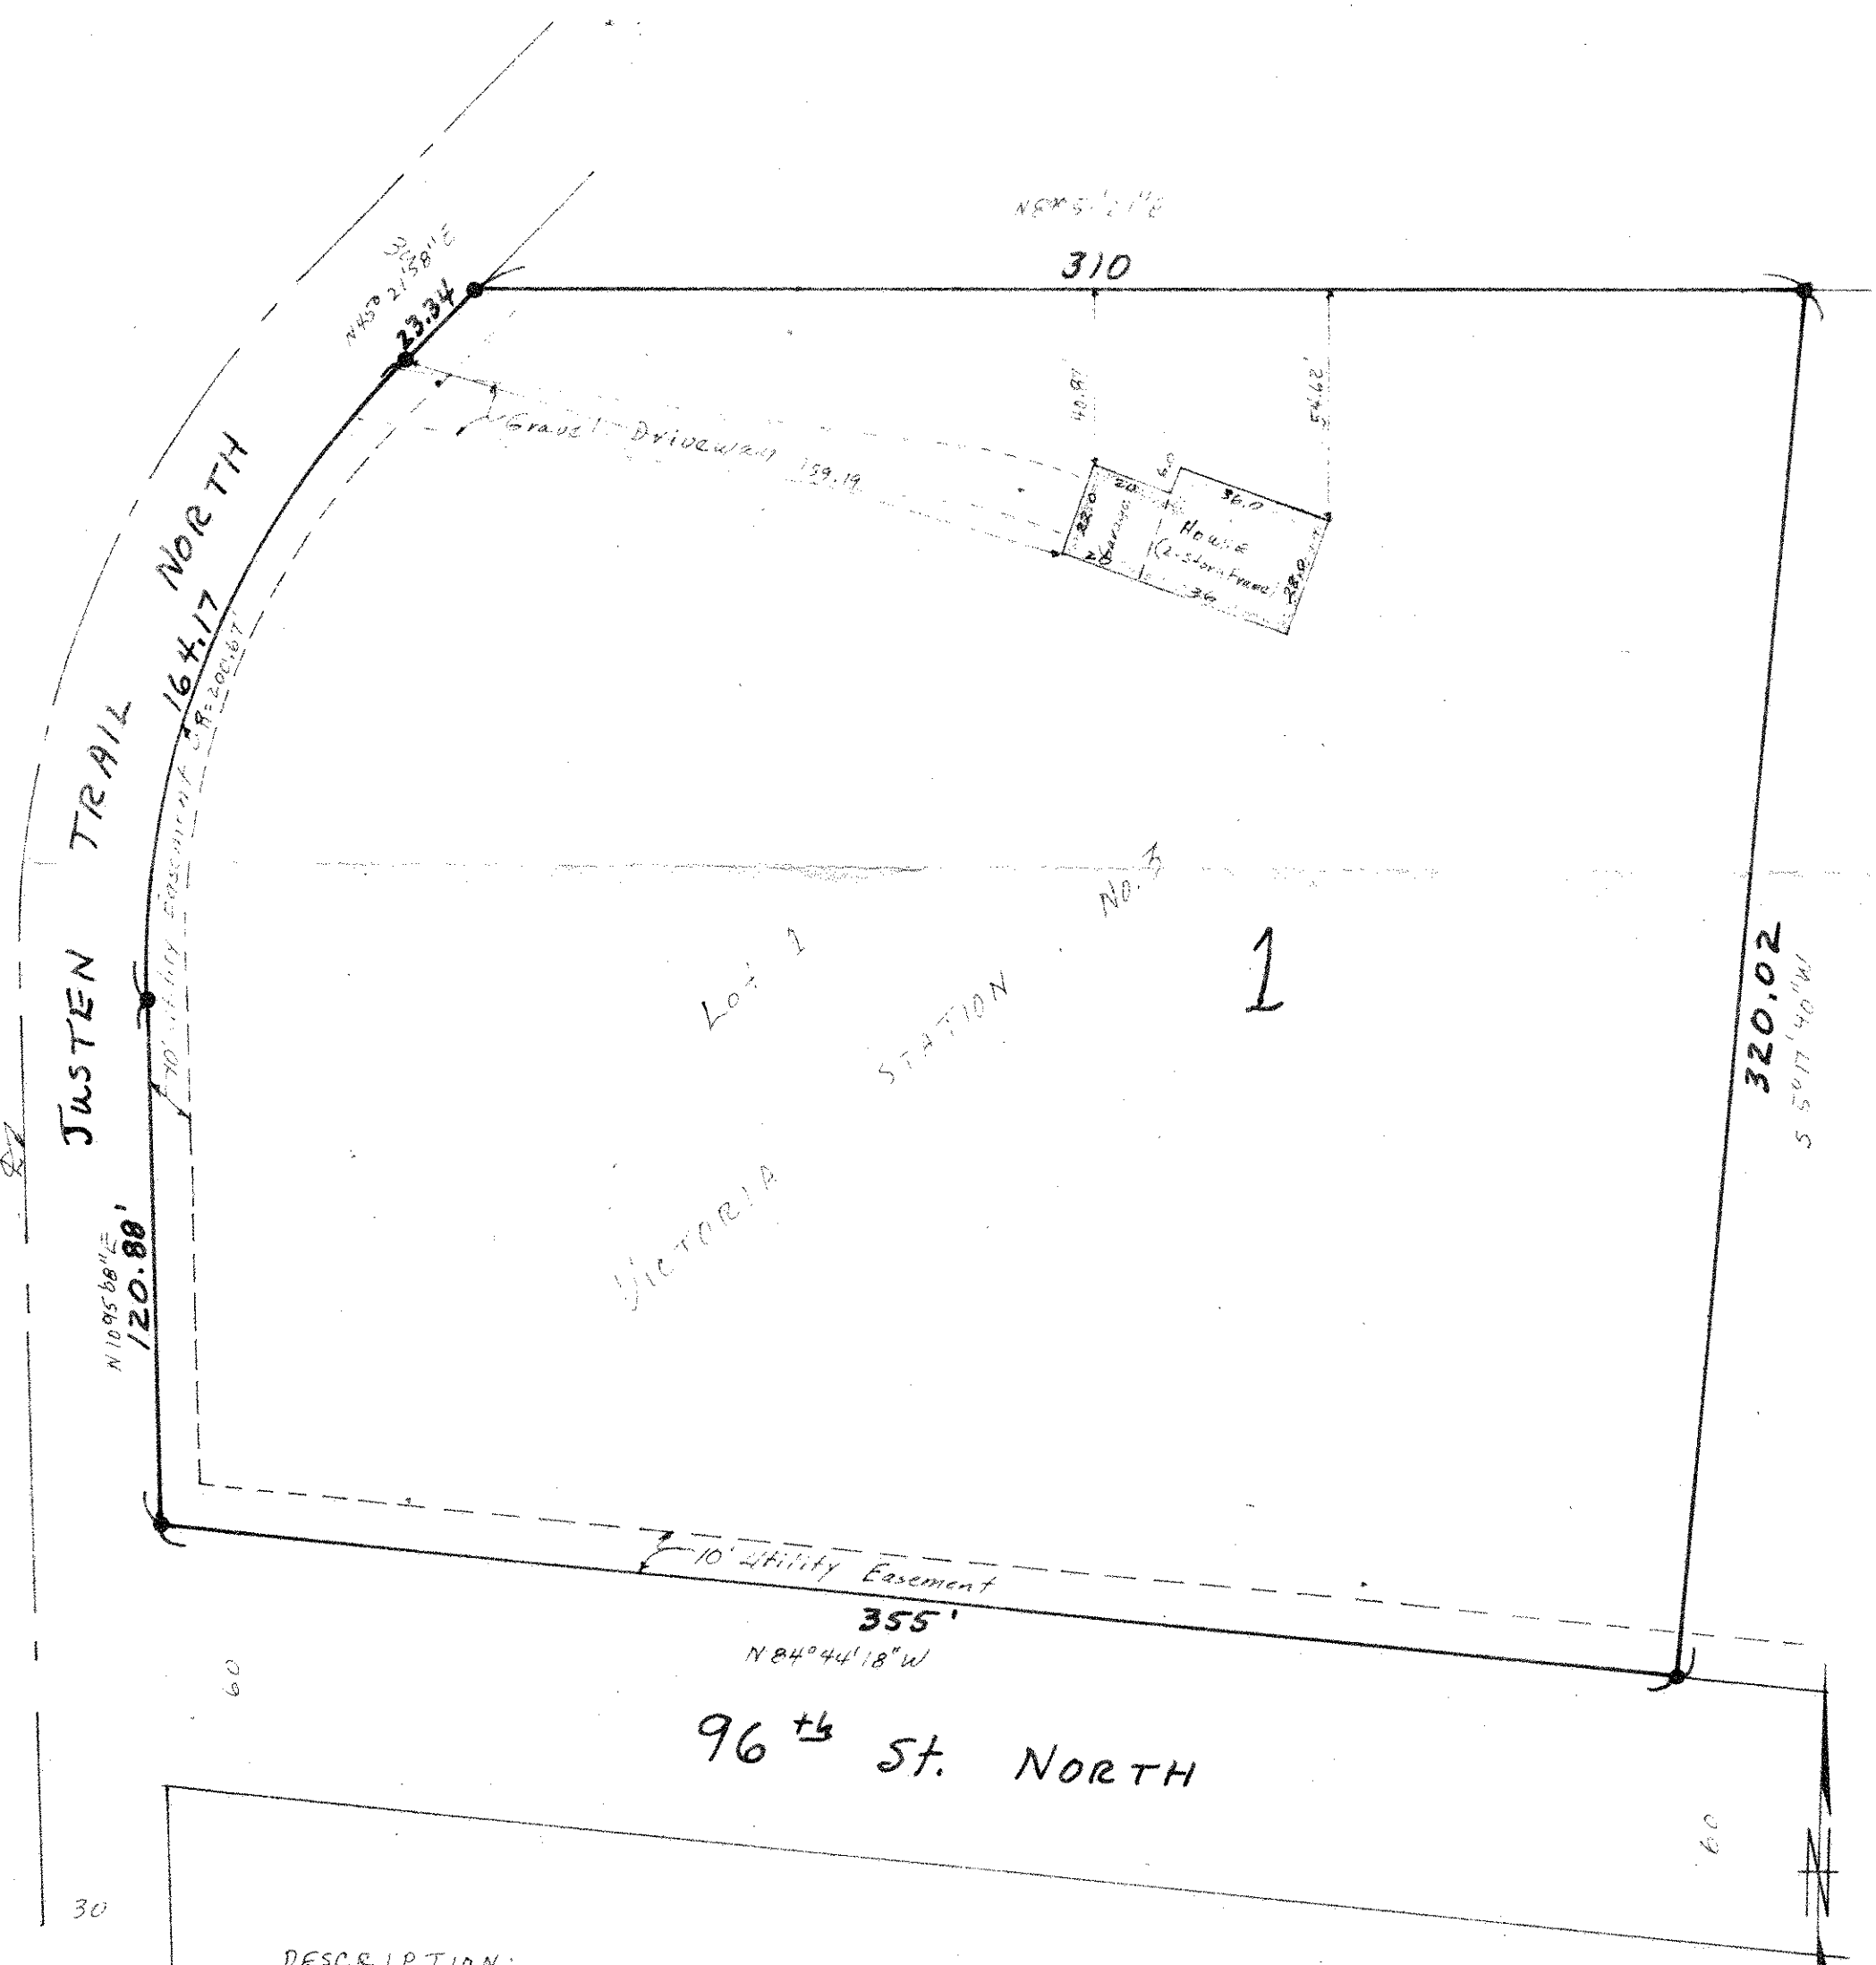

DESCRIPTION:

Lot 1, Block 1, Victoria Station No. 3  
Washington County, Minnesota

• Denotes Iron Found in place & Verified