

WILDWOOD ADD.
BLK 129.

GRANT


ST.

ST

AVE

MAGNOLIA

HAZEL

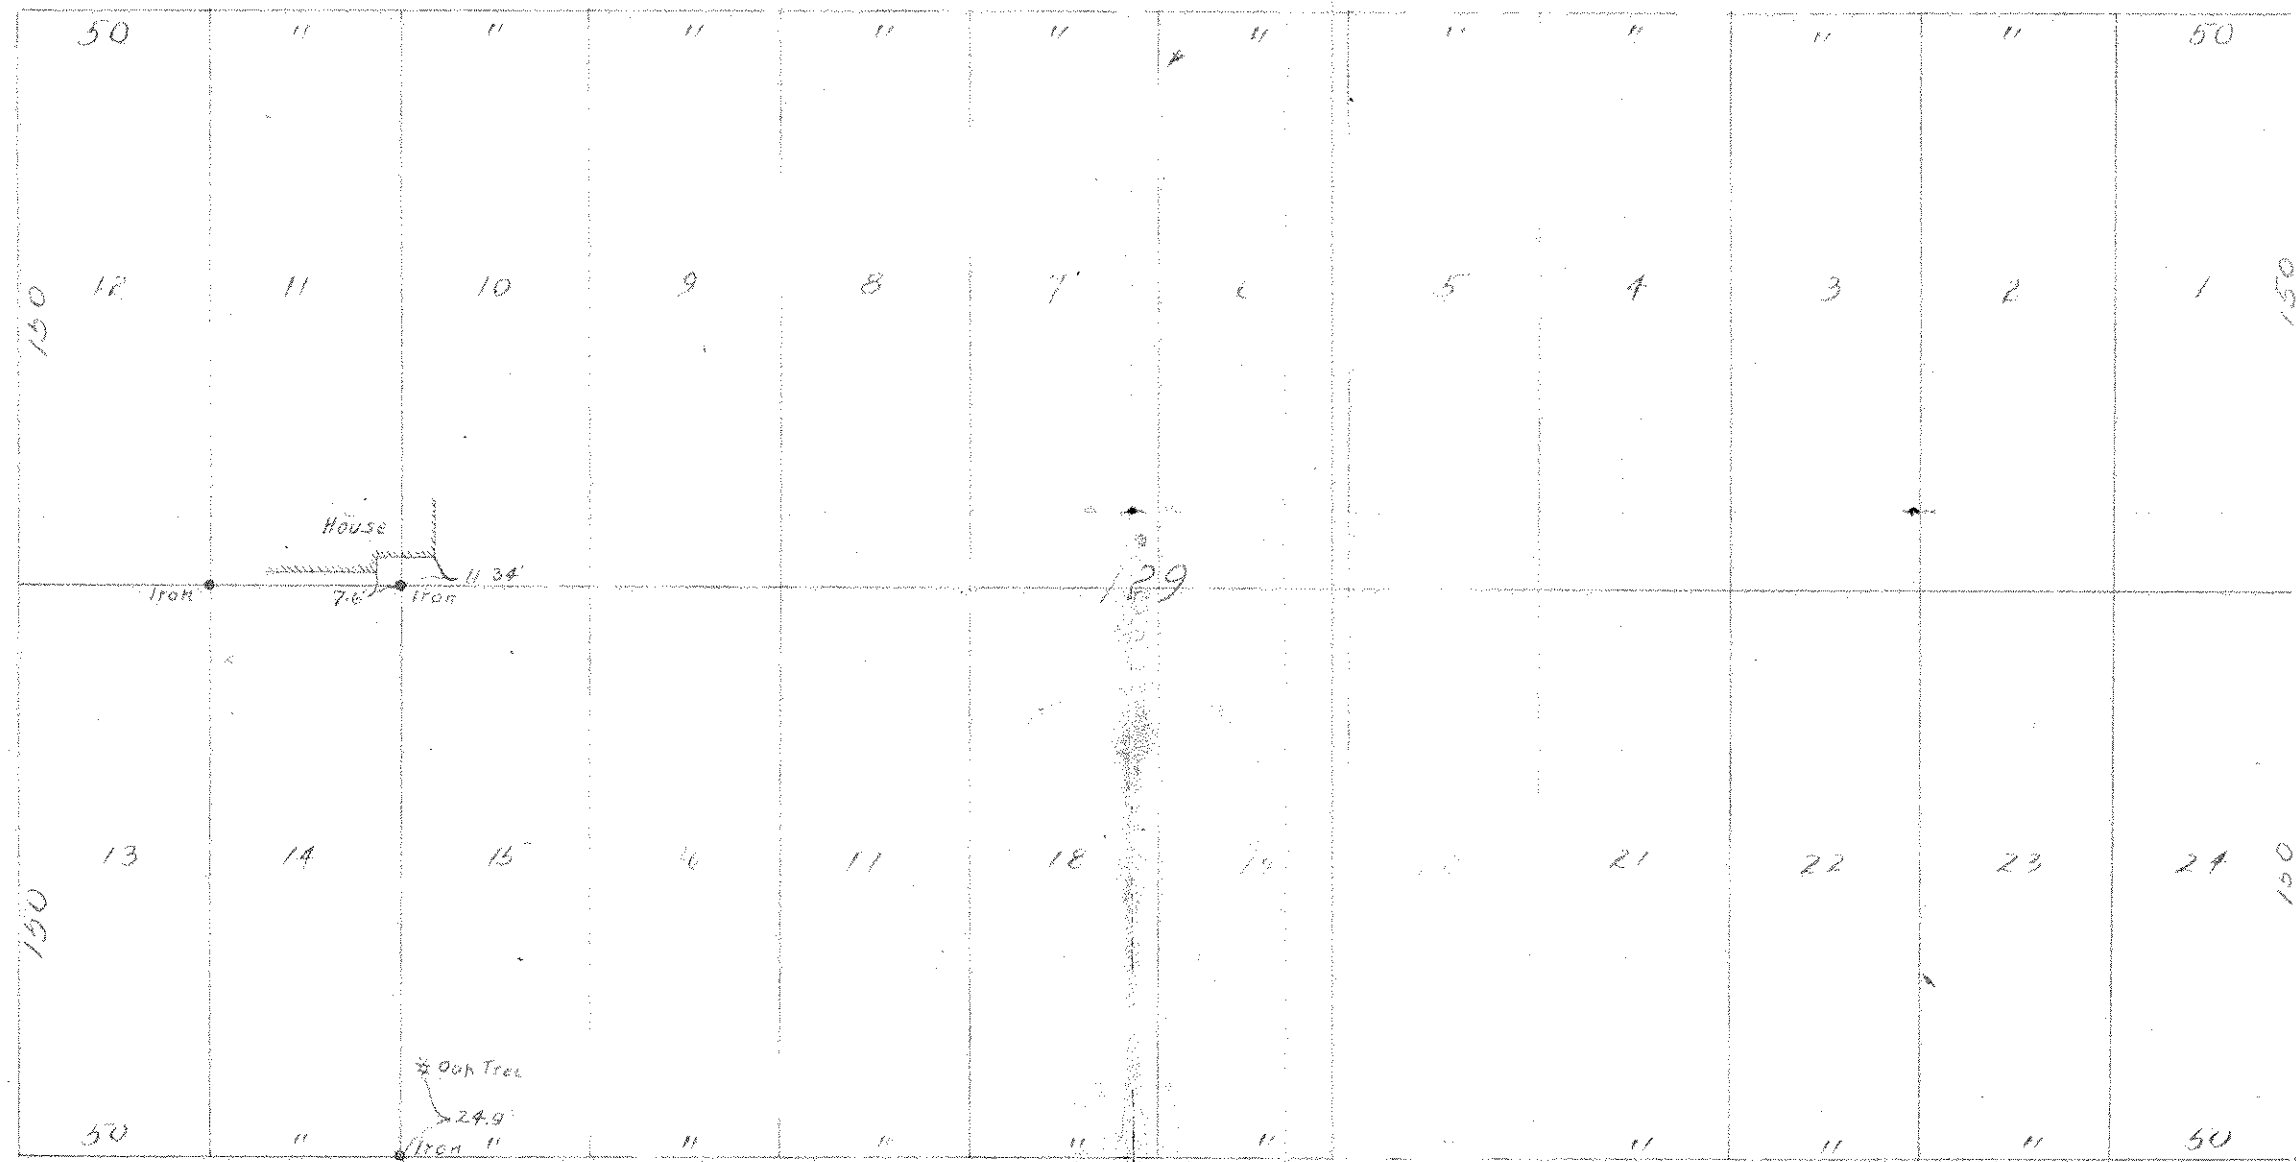

LANE

AVE.