
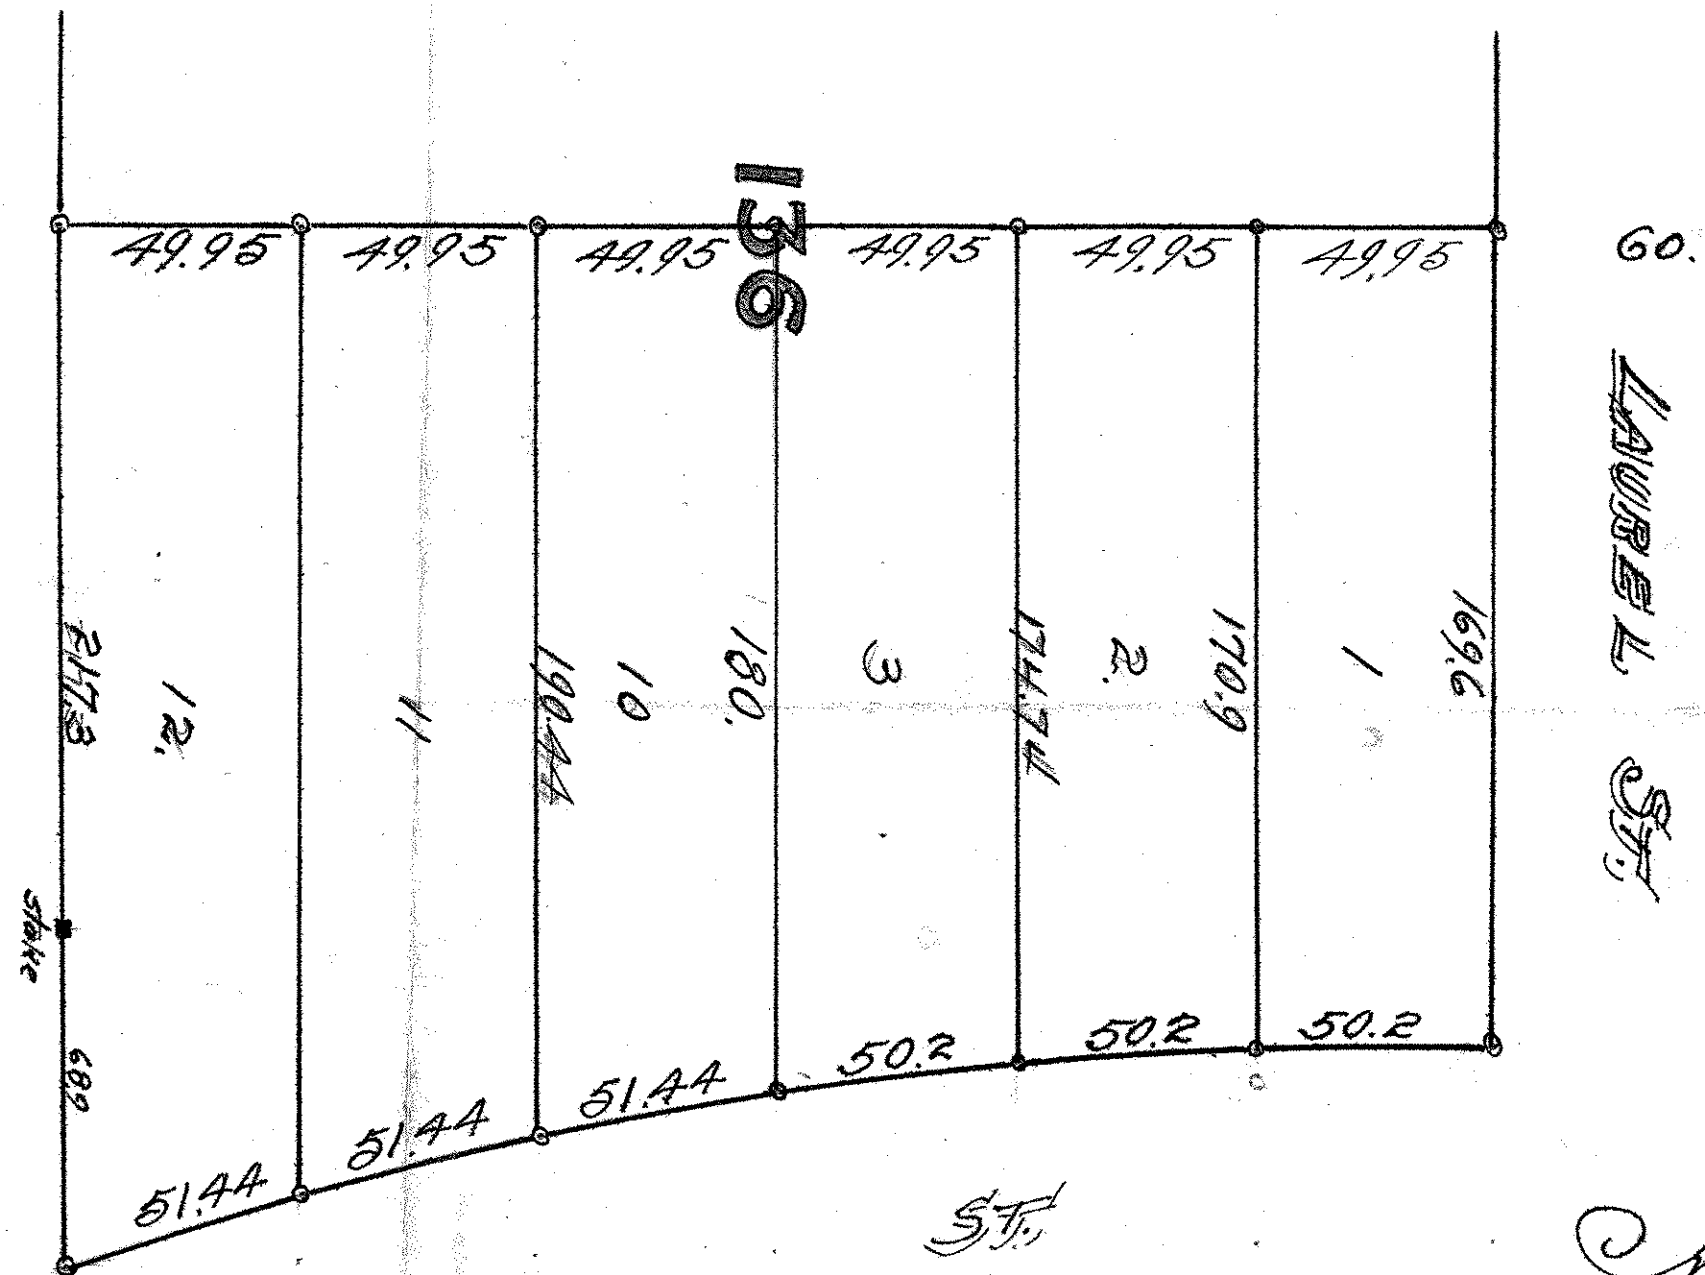


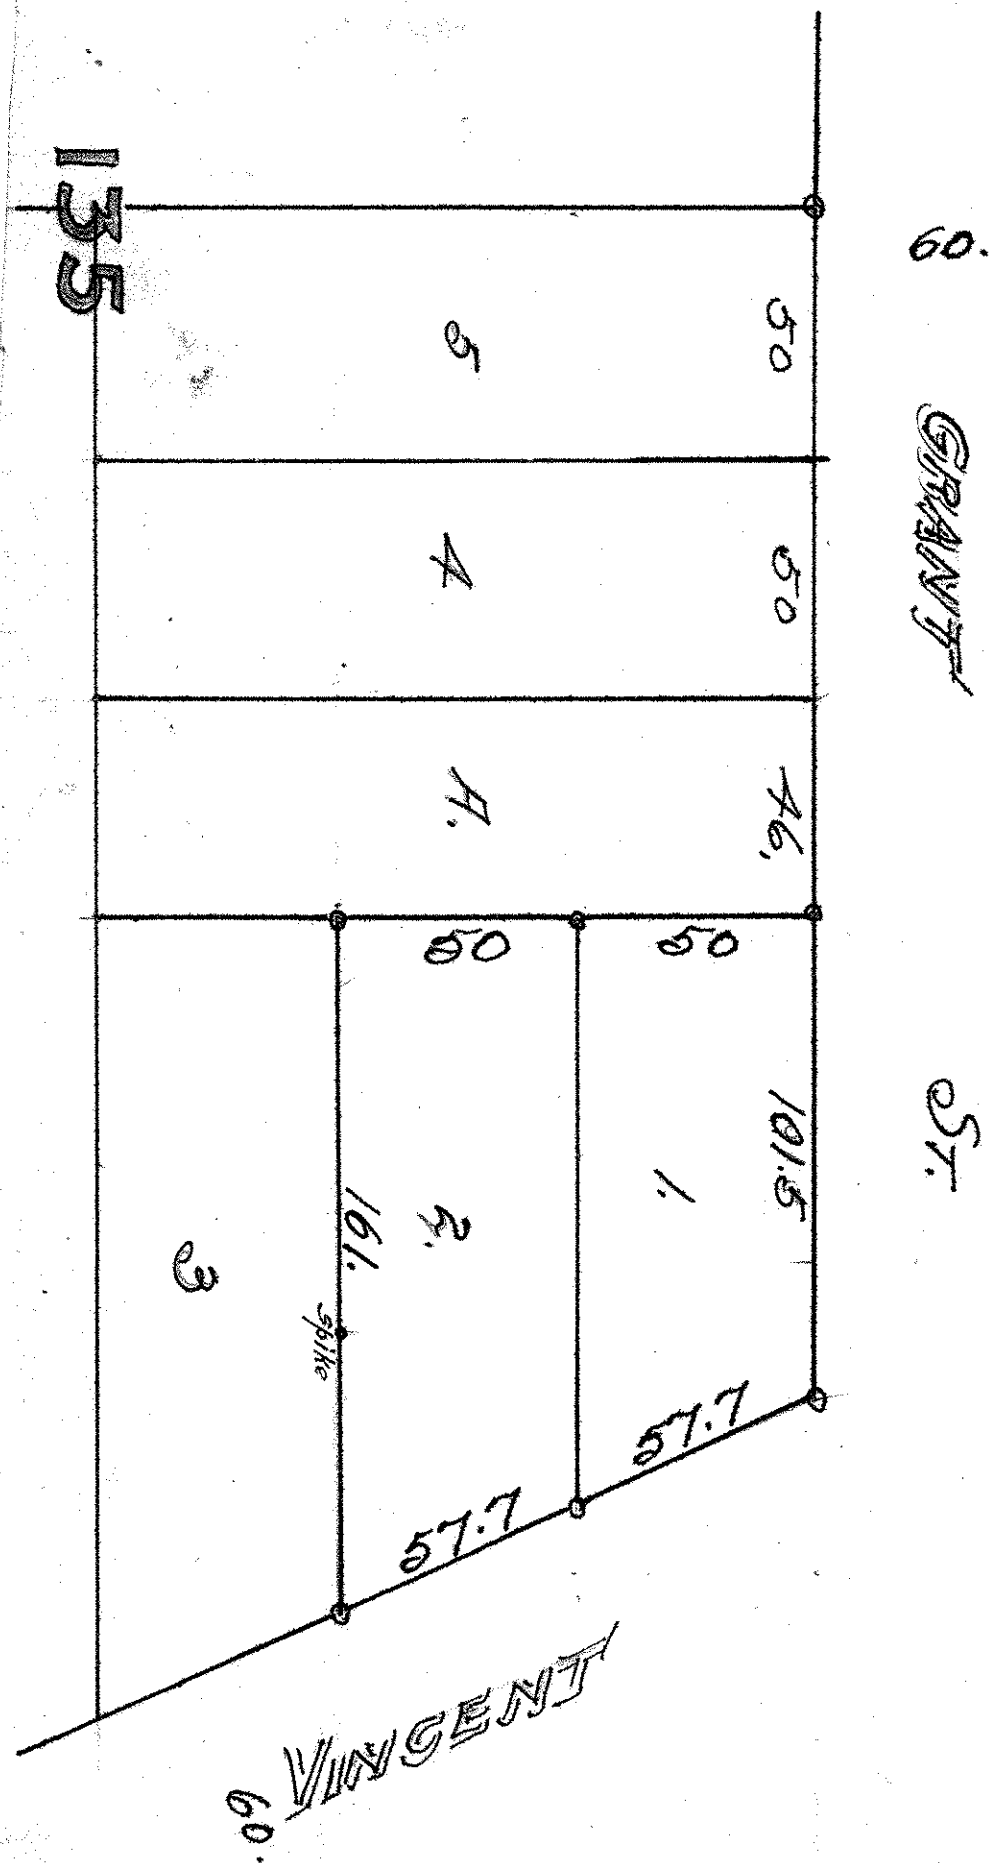

LOTS 2-3-10-11-12 BLOCK 136.
 LOTS 1 & 2 BLOCK 135.

WILLOWWOOD.

John B. Irvine, Surveyor.

June 24-1920.

Scale 40 ft. per inch.