

TELEPHONE 776-0640

PLAT OF SURVEY


OF PROPERTY OF John Anderson
 DESCRIBED AS FOLLOWS Lots 26 and 27, Block 23, Wildwood Manor

W

SCALE: 1 INCH = 30 FEET

o DENOTES IRON

T. J. WELCH, REGISTERED SURVEYOR
 701 EAST 3RD STREET, ST. PAUL, MINN. 55106

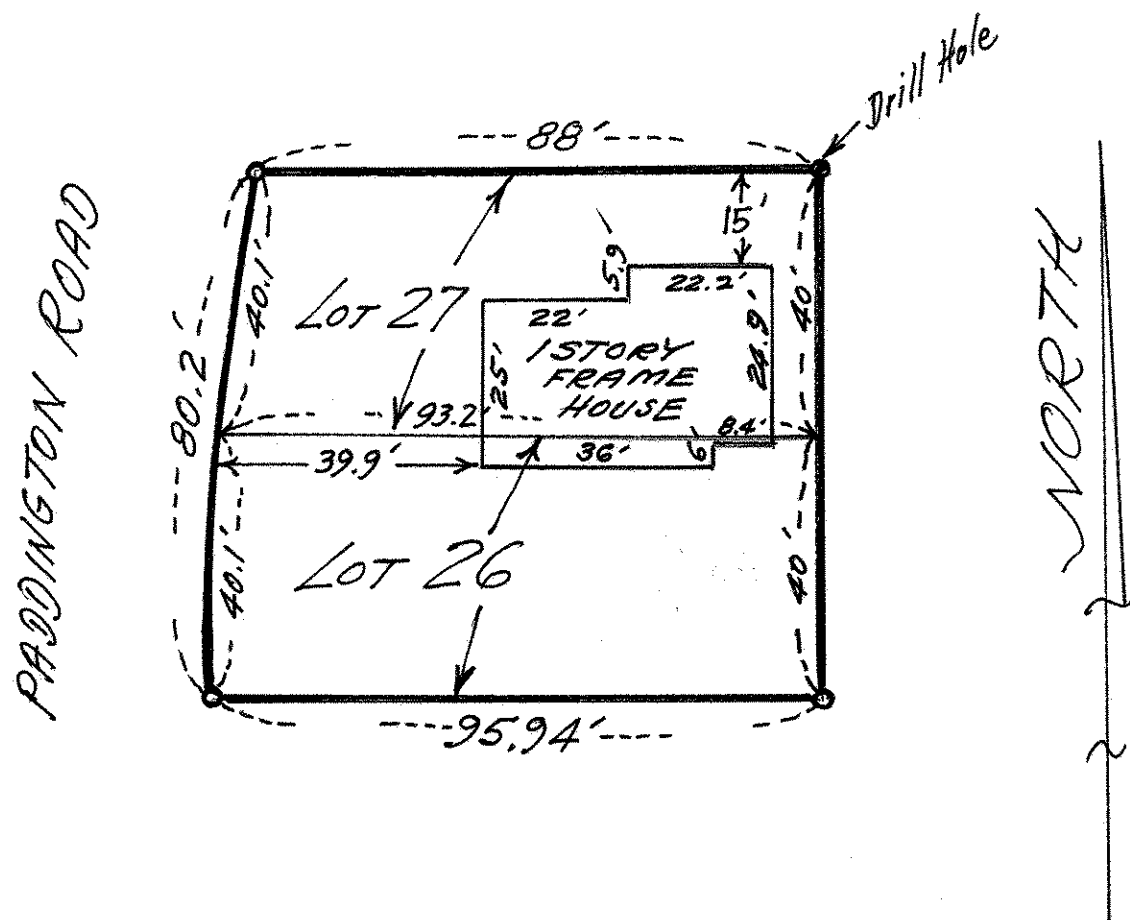

CERTIFICATE OF SURVEY

I hereby certify that on October 3, 1970
 I surveyed the property described above and that the above
 plat is a correct representation of said survey.

T. J. Welch

343/
69