


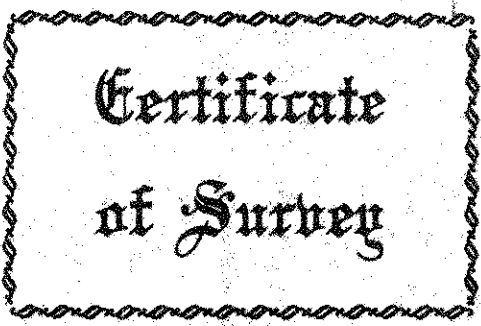

From the office of
GEORGI-SCHMIDT & ASSOC. INC.
3092 No. Lexington Ave., Roseville, Mn. 55113
LAND SURVEYING
483-4408


I Hereby Certify that this plat shows a survey made by me of the property described on this plat, and that the corners are correctly placed as shown, and that all locations have been correctly shown.

Job Number: 520
Surveyed For Lyle Hoar
Date 10/29/79
Scale 1"=30'

By Donald W. Schmidt
REGISTERED LAND SURVEYOR

DESCRIPTION:

Lots 4, 5, 6, and 7, Block 40,
Wildwood Manor
Washington County, Minnesota

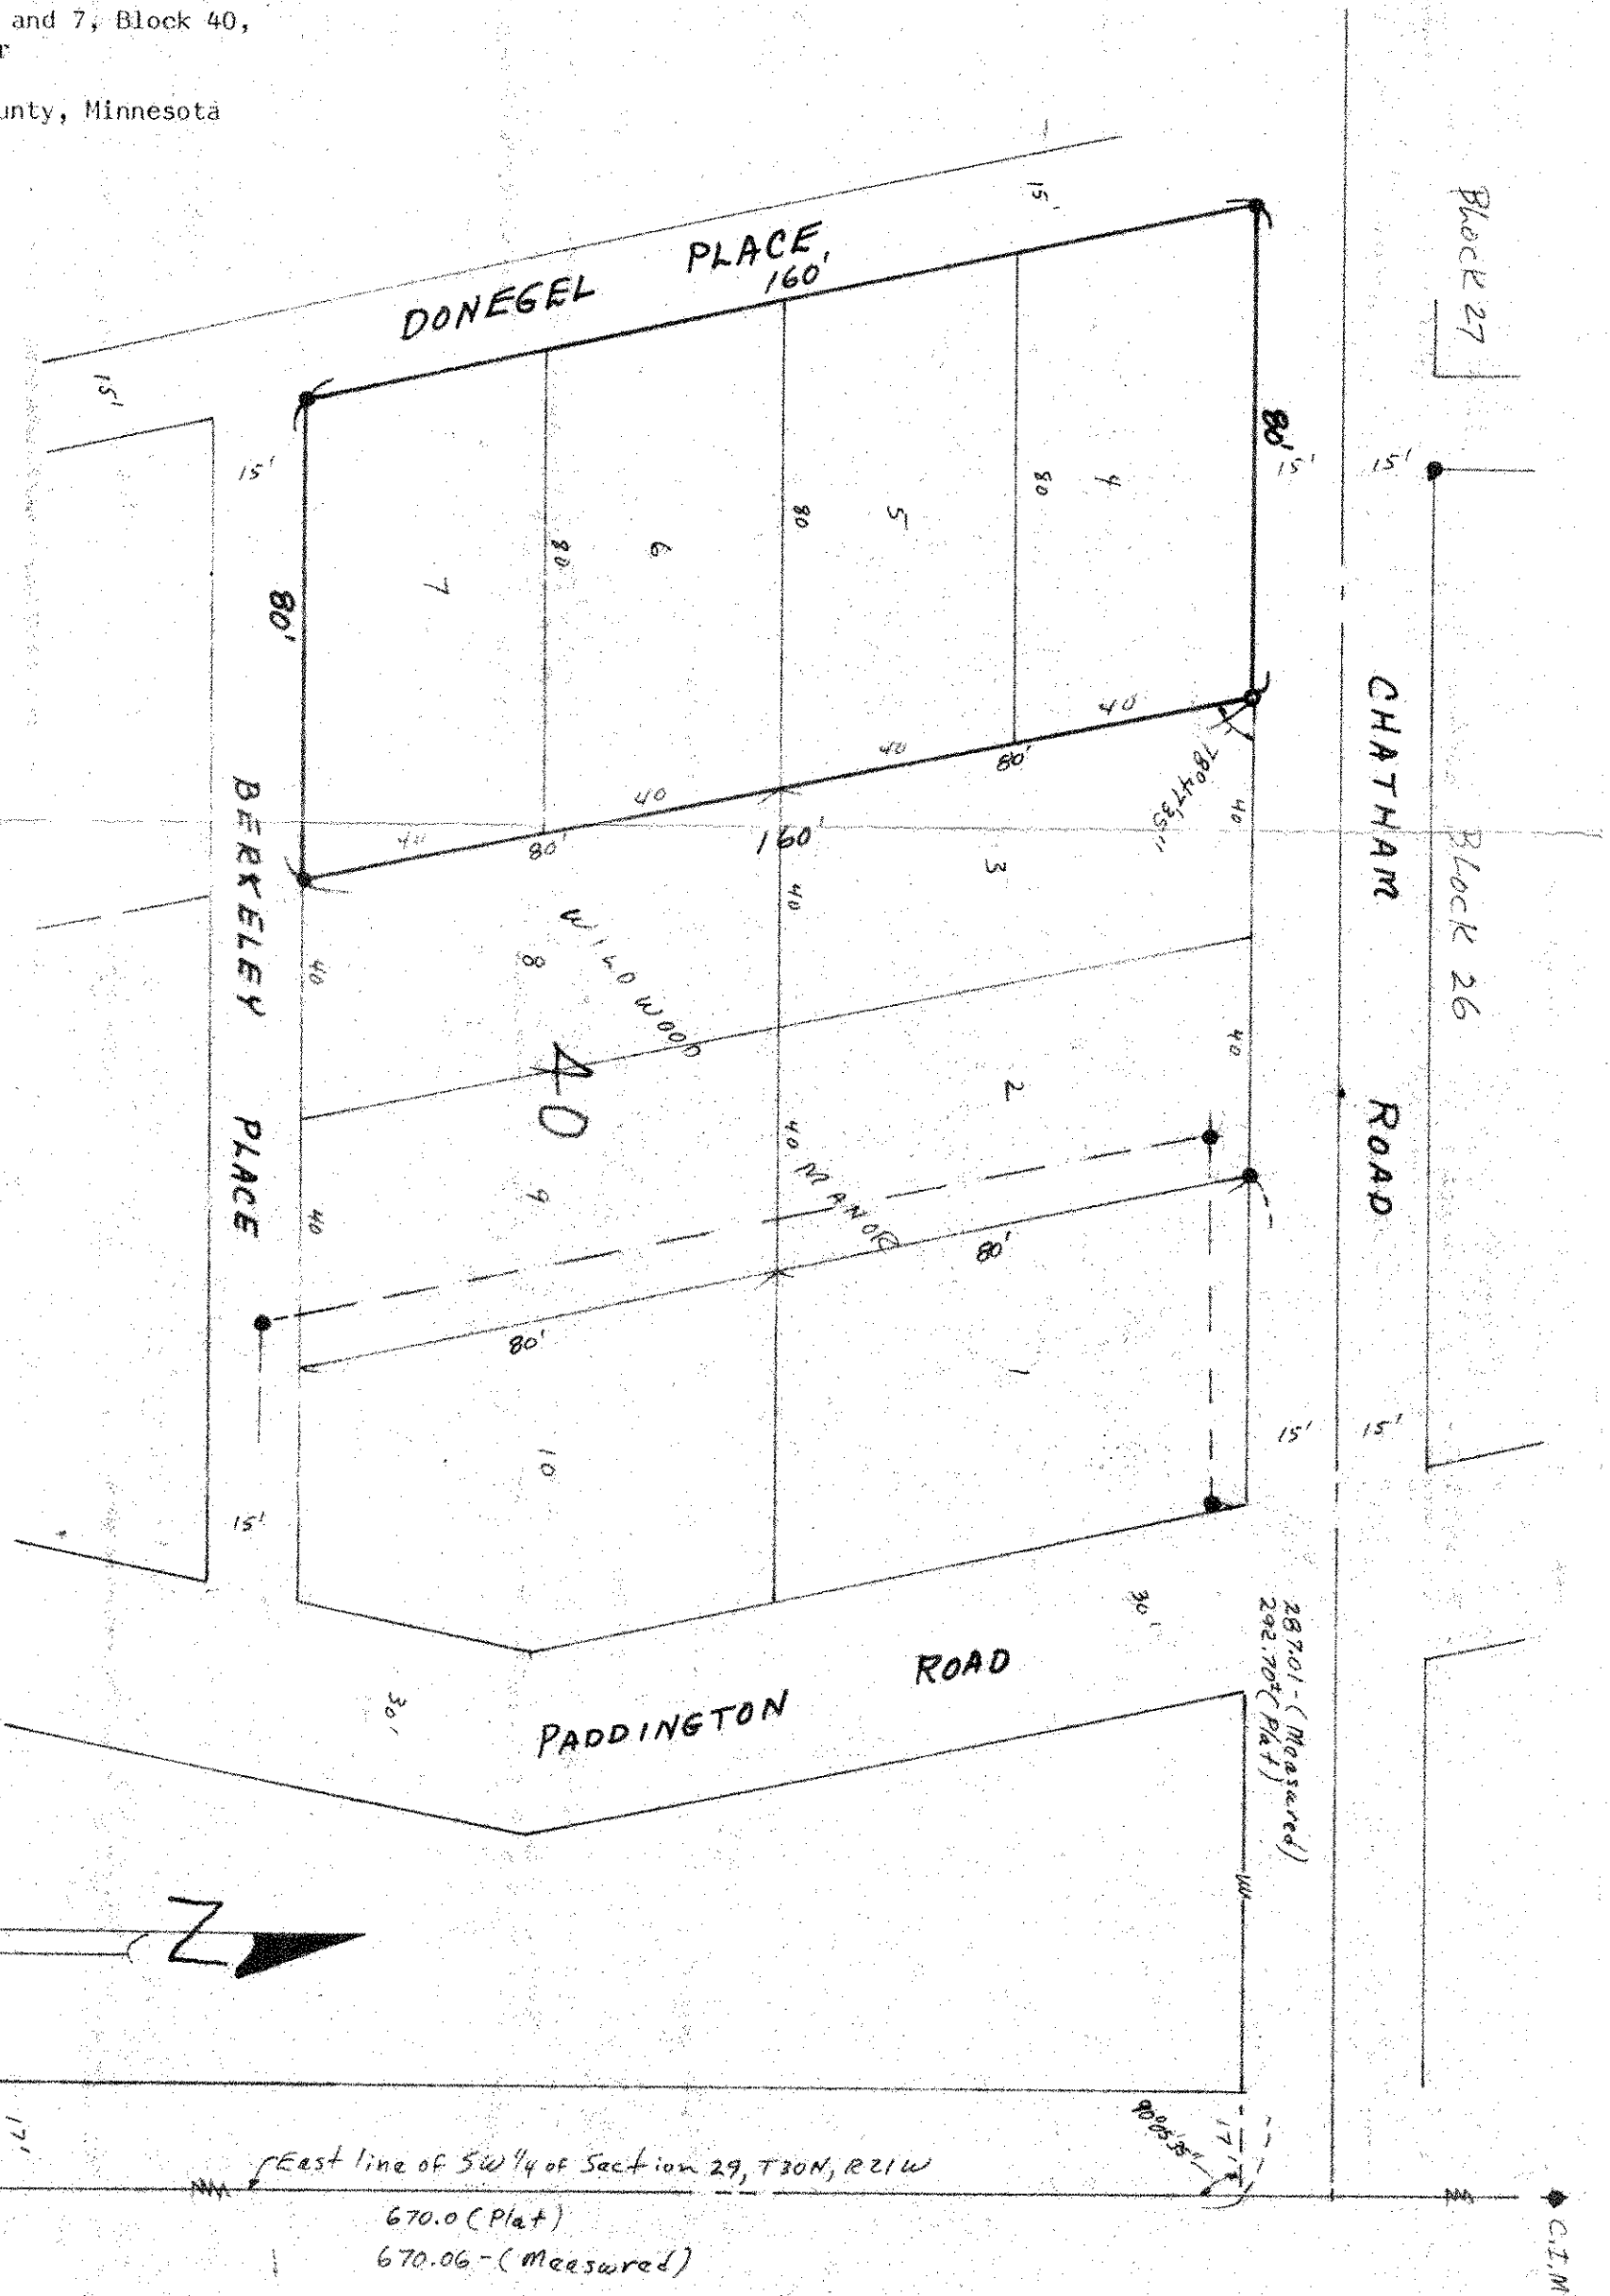

• Denotes Iron Found in place
○ Denotes Iron Monument Set

Q.T.M. @
SW Corner