

TELEPHONE 776-0640

PLAT OF SURVEY


OF PROPERTY OF James Hicky
DESCRIBED AS FOLLOWS Lots 1 and 2, Block 24, Wildwood Manor,
Washington County, Minnesota.

SCALE: 1 INCH = 30 FEET

o DENOTES IRON

T. J. WELCH, REGISTERED SURVEYOR
701 EAST 3RD STREET, ST. PAUL, MINN. 55106

WEBSTER AVE.

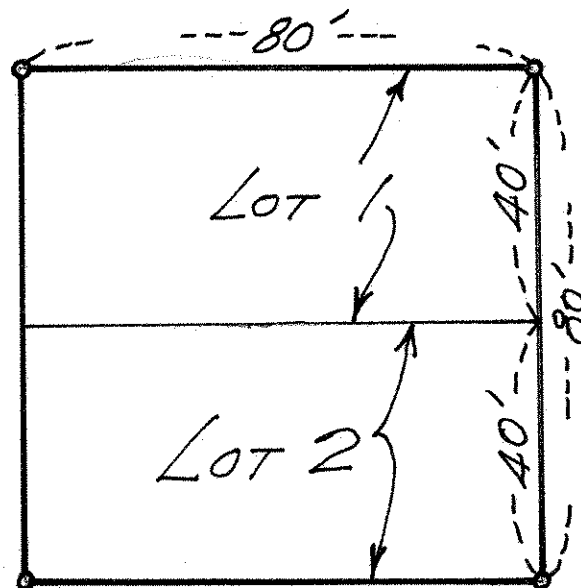

BEACONSFIELD ST.

NORTH

CERTIFICATE OF SURVEY

I hereby certify that on June 6, 1970
I surveyed the property described above and that the above
plat is a correct representation of said survey.

T. J. Welch

343/
12