


SW 29 30 21

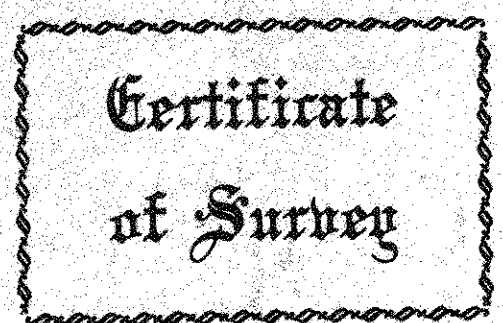

From the office of
GEORGI SCHMIDT & ASSOC. INC.
3092 No. Lexington Ave., Roseville, Mn. 55113
LAND SURVEYING
483-4408

I Hereby Certify that this plat shows a survey made by me of the property described on this plat, and that the corners are correctly placed as shown, and that all locations have been correctly shown.

Job Number: 520
Surveyed For Lyle Hoble
Date 10/29/79
Scale 1"=30'

By Donald W. Schmidt
REGISTERED LAND SURVEYOR

DESCRIPTION:
Lots 8 and 9, Block 40,
Wildwood Manor
Washington County, Minnesota

