


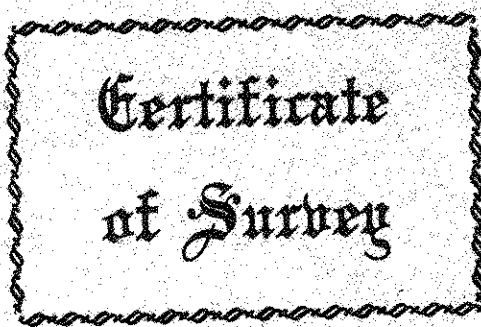

From the office of
GEORGI-SCHMIDT & ASSOC. INC.
 3092 No. Lexington Ave., Roseville, Mn. 55113
 LAND SURVEYING
 483-4408


I Hereby Certify that this plat shows a survey made by me of the property described on this plat, and that the corners are correctly placed as shown, and that all locations have been correctly shown.

Job Number: 520
 Surveyed For: Lyle Hoble
 Date: 10/24/79
 Scale: 1" = 30'

By: Donald W. Schmidt
 REGISTERED LAND SURVEYOR

DESCRIPTION:

Lots 2 and 3, Block 40,
 Wildwood Manor
 Washington County, Minnesota

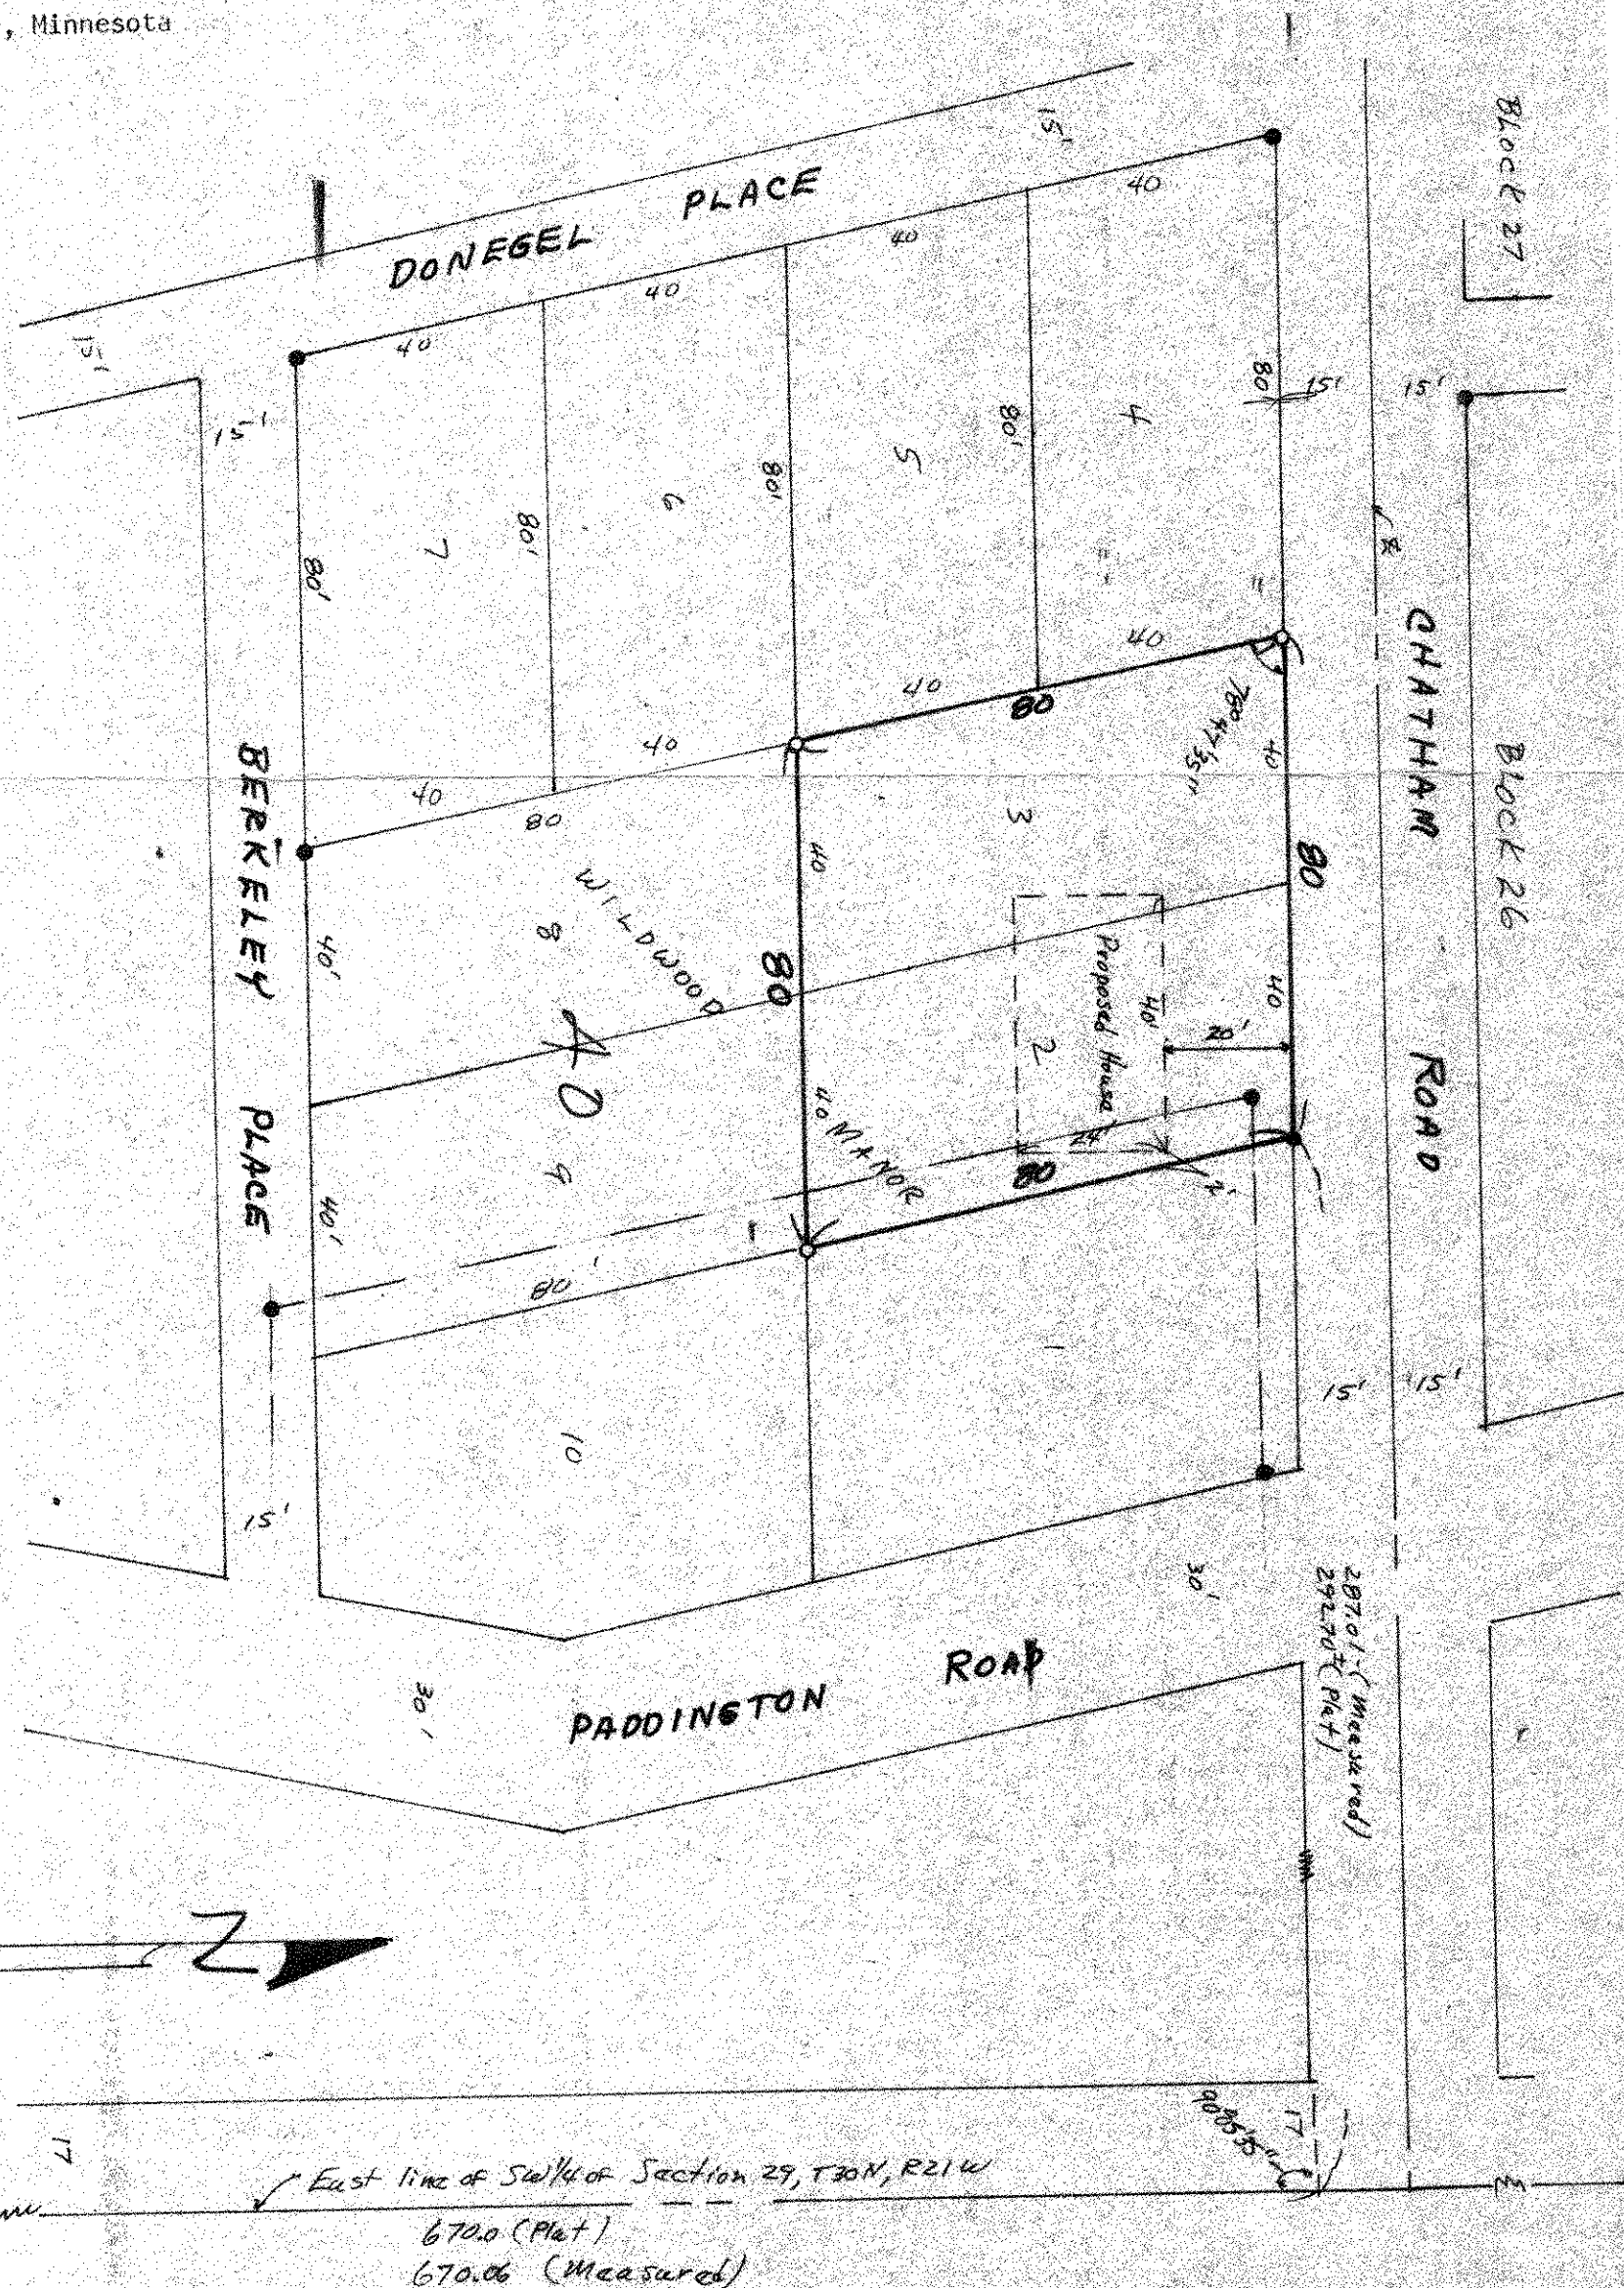

• Denotes Iron Found in place
 o Denotes Iron Monument Set

C.I.M.
 S 1/4 Corner

East line of SW 1/4 of Section 29, T30N, R21W
 670.0 (Plat)
 670.06 (Measured)

C.I.M.