

Mont.
1/4 COR.
N. Line
Sec. 29.

SOUTH 132 ft. of NORTH 411 ft. of
N.W. 1/4 OF S.W. 1/4 of N.E. 1/4
SECTION 29, T. 30, R. 21,

N

JOHN B. IRVINE, SURVEYOR.

408 GLOBE BLDG.


ST. PAUL, MINN.

JUNE 4th 1915

Scale 200 ft per inch.

• INDICATES IRONS

■ " STAKES.

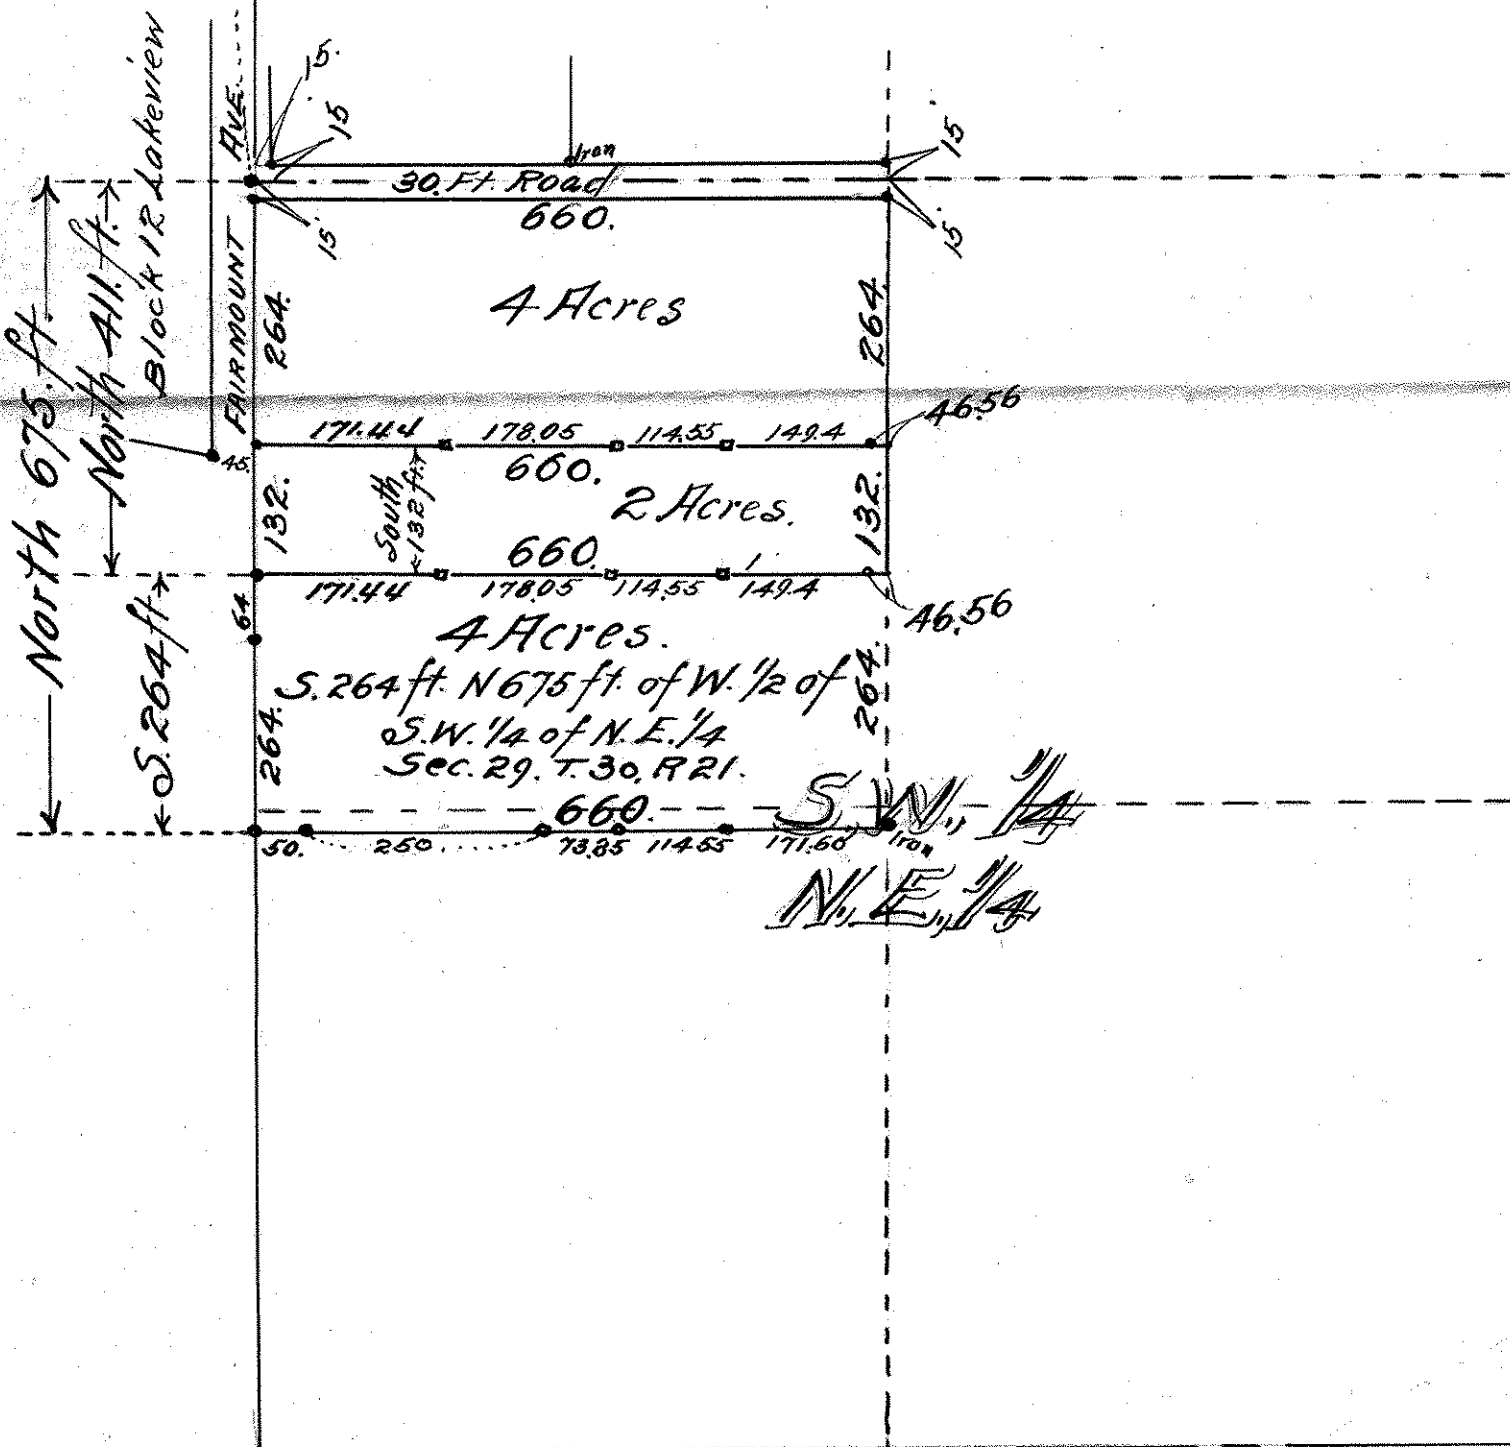

S. 264 ft. N. 675 ft.

Surveyed Oct. 18-1915.

J. B. Irvine, Surveyor.