

Certificate of Survey

CHARLES O. GEORGI COMPANY

2215 West County Road B

Saint Paul, Minnesota 55118

REGISTERED CIVIL ENGINEER AND LAND SURVEYOR

I Hereby Certify that this plat shows a survey made by me of the property described on this plat, and that the corners are correctly placed as shown, and that all locations have been correctly shown.

12/30/69 Added CORNER IRONS.

Surveyed For Gerald Mogren

Date December 1969

Scale 1" = 500'

By Charles O. Georgi
REGISTERED LAND SURVEYOR


Description:

All that part of the SW 1/4 of Section 26-T30-R21 lying Southerly of the following described line; beginning at a point on the West line of said Section 26, distant 316.9 feet North (assumed bearing) of the S.W. corner of said Section 26; thence N 78° 36' 23" E a distance of 2666.1 feet, more or less, to the East line of the SW 1/4 of said Section 26; thence Southerly along the East line of said Section 26 a distance of 781.5 feet, more or less, to the South Qtr. corner of said Section 26 and there terminating.

Subject to Town Road.
Contains 33.0 Acres, more or less.

North Line of S.W. 1/4 of Section 26-T30-R21

TOWN ROAD (Paved)

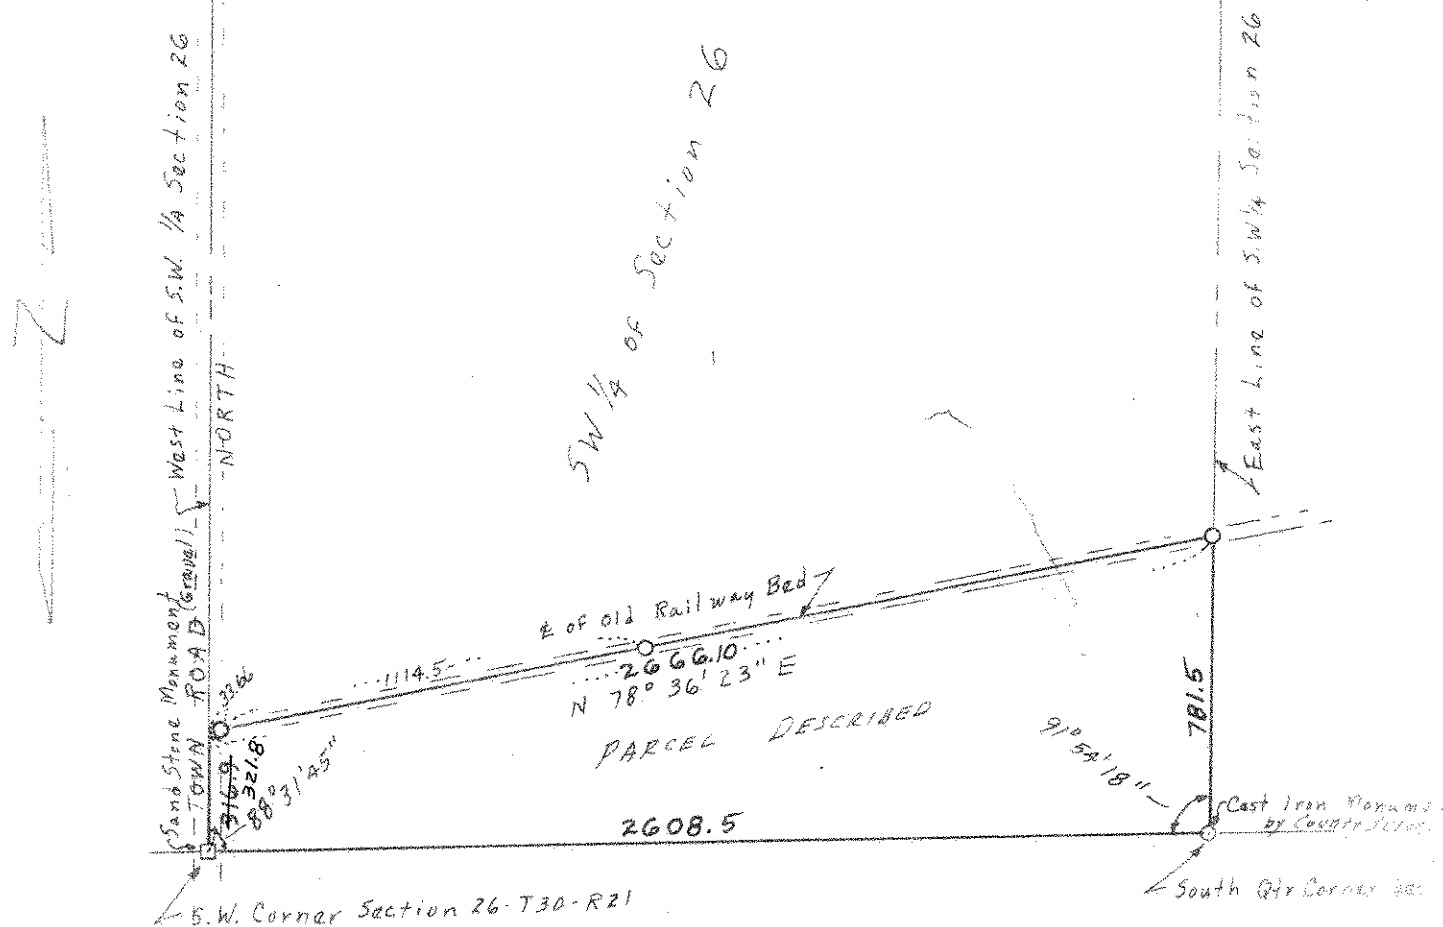

○ Denotes Iron Monument